

HAR. B38
5-64

MISSISSIPPI BOARD OF WATER COMMISSIONERS

T 171407

WATER WELL DRILLERS LOG

CODED

Date: May, 1964, Driller: Joe Miller County Harrison
(Name)

(1) Owner of Land: John Myers
(Name)
RR# 1 Saucier Miss
(Address) 23 5512

(2) Location: 1/4, 1/4, Sec. 0 TORO
18 miles North of Shelford
(distance) (direction) (Nearest Town)

(3) Topography: Hilly
(Hilly) (Flat) (Level)

(4) Purpose of Well: Domestic
(Domestic Irrigation
Municipal, Industrial, Other)

Description & Color of Materials Sand, Clay, Red Clay, Shell, etc.	Thick- ness Feet	Depth Feet
<u>Surface</u>	<u>5</u>	<u>5</u>
<u>Red Clay Red Sands</u>	<u>35</u>	<u>40</u>
<u>White Clay</u>	<u>17</u>	<u>57</u>
<u>Dark Blue Clay</u>	<u>13</u>	<u>70</u>
<u>Light Blue Clay</u>	<u>10</u>	<u>80</u>
<u>White Clay</u>	<u>40</u>	<u>120</u>
<u>Softer, Zone Ten Sand Mt.</u>	<u>25</u>	<u>145</u>
<u>Blue Clay</u>	<u>51</u>	<u>196</u>
<u>Break. of G. Ten Sand</u>	<u>18</u>	<u>206</u>
<u>Hard Blue Clay</u>	<u>62</u>	<u>268</u>
<u>Zone Gray sand</u>	<u>16</u>	<u>284</u>
<u>Gray Sand (Fair)</u>	<u>11</u>	<u>295</u>
<u>Gray Sand (Good)</u>	<u>30</u>	<u>325</u>
	<u>2</u>	<u>327</u>

Information upon completion of well:

(1) Diameter 2" inches.

(2) Total Depth 327' feet.

(3) Water Level 52' feet below top of ground.

(4) Cased to 315', Size 2"

(5) Screen: Size 2", Length 10'

(6) Were any formations sealed against pollution?
_____ yes, _____ no.


Still in Sand

CODED

If YES depth of formation _____

Why _____

Drillers Remarks: _____

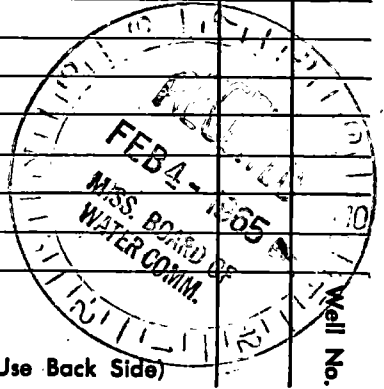

over

(Use Back Side)

Well No.

