

**HARRISON**  
**B 40**  
**5-11-70**

MISSISSIPPI  
 BOARD OF WATER COMMISSIONERS  
 416 North State Street  
 Jackson, Mississippi 39201

**CODED**

WATER WELL DRILLERS LOG

5-11 1970 Farnell Anderson Harrison  
 date well completed firm name county well located

LANDOWNER: A. L. Sardos  
McHenry  
 (mailing address)

description of formations encountered	from	to
TOP Soil	0	2
Red Clay	2	19
FINE SAND	19	28
Blue Clay	28	44
FINE SAND	44	56
COURSE SAND	56	68

WELL LOCATION:  
 sec. 27 T 4 N R 12 W  
8 miles West of McHenry  
 (distance) (direction) (nearest town)

WELL PURPOSE: Home  
 (home, irrigation, municipal, industrial)

WELL COMPLETION DATA:

(1) diameter (inches) 2  
 (2) total depth (feet) 68  
 (3) static water level (feet) 30 below top of ground.  
 (4) casing Plastic, 62,  
 (material) (depth)  
 \_\_\_\_\_ If telescope see back.  
 (size)  
 (5) screen 6, 62  
 (length) (depth to top)  
2", Plastic  
 (size) (material)  
 (6) pump 1, 9  
 (HP) (yield gpm)  
Elect  
 (type power)  
 (7) electric log (yes or no)  
 \_\_\_\_\_  
 (organization running log)

**CODED**

(8) how well bottom plugged  
Back with 4 1/2" pipe


JUN 11 1971

DRILLERS REMARKS:

MISS. BD. OF  
 WATER COMM.

If well telescopes please sketch and show depths.

GROUND LEVEL

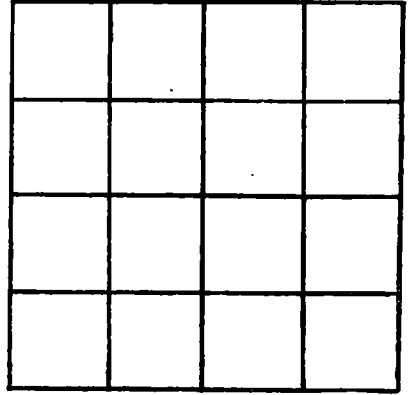

SECTION \_\_\_\_\_

Please indicate well location X.

ADDITIONAL INFORMATION

If more than one screen, show locations of each on sketch.