

~~HARRISON~~
 B41
 3-18-71

MISSISSIPPI
 BOARD OF WATER COMMISSIONERS
 416 North State Street
 Jackson, Mississippi 39201

CODED

WATER WELL DRILLERS LOG

March 18, 1971 Lodnie's Well Works Union
 date well completed firm name county well located

LANDOWNER <u>Johnny Daniel</u>	description of formations encountered	from	to
<u>Rt. 1</u> <u>Saucier, Miss.</u> (mailing address)	<u>yellow clay</u> <u>Blue clay</u> <u>Blue sand</u>	<u>0</u> <u>40</u> <u>240</u>	<u>40</u> <u>240</u> <u>290</u>
WELL LOCATION: sec <u>1</u> T <u>4</u> N R <u>12</u> E <u>12</u> miles <u>W</u> of <u>Saucier</u> (distance) (direction) (nearest town)			
WELL PURPOSE: <u>home</u> (home, irrigation, municipal, industrial)			
WELL COMPLETION DATA:			
(1) diameter (inches) <u>2 inch</u>			
(2) total depth (feet) <u>300 ft.</u>			
(3) static water level (feet) <u>50</u> <u>below</u> top of ground.			
(4) casing <u>Galv.</u> <u>290 ft.</u> (material) (depth)			
<u>2 inch</u> If telescope see back. (size)			
(5) screen <u>10 ft.</u> <u>290 ft.</u> (length) (depth to top)			
<u>2 inch</u> <u>SS</u> (size) (material)			
(6) pump <u>1</u> <u>6 gal.</u> (HP) (yield gpm)			
<u>elec.</u> (type power)			
(7) electric log <u>no</u> (yes or no)			
(organization running log)			
(8) how well bottom plugged <u>Ball Check</u>			
DRILLERS REMARKS:			


CODED

JUL 21 1971

MISS. BD. OF
 WATER COMMISSIONERS

If well telescopes please sketch and show depths.

GROUND LEVEL

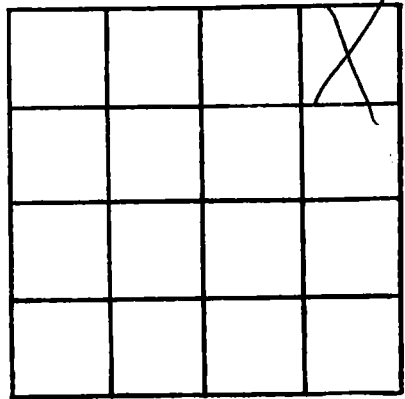

SECTION 1

Please indicate well location X.

ADDITIONAL INFORMATION

If more than one screen, show locations of each on sketch.