

HARRISON
B 46
7-3-22

MISSISSIPPI
 BOARD OF WATER COMMISSIONERS
 416 North State Street
 Jackson, Mississippi 39201


WATER WELL DRILLERS LOG

July 3 1972 hadwiger's Well Works HARRISON
 date well completed firm name county well located

LANDOWNER: <u>MR. RONNIE TORRES</u>	description of formations encountered	from	to
<u>YANKEE ROAD</u>	<u>YELLOW CLAY</u>	<u>0</u>	<u>30</u>
<u>SAUCIER, MISS.</u> (mailing address)	<u>BLUE CLAY</u>	<u>30</u>	<u>220</u>
WELL LOCATION: sec. <u>4</u> T. <u>5</u> R. <u>12</u> <u>3</u> miles <u>WEST</u> of <u>SAUCIER</u> (distance) (direction) (nearest town)	<u>BLUE SAND</u>	<u>220</u>	<u>294</u>
WELL PURPOSE: <u>HOME</u> (home, irrigation, municipal, industrial)			
WELL COMPLETION DATA:			
(1) diameter (inches) <u>2 inch</u>			
(2) total depth (feet) <u>304 FT.</u>			
(3) static water level (feet) <u>30</u> below top of ground.			
(4) casing <u>Galv.</u> , <u>294 FT.</u> (material) (depth)			
<u>2 inch</u> If telescope see back. (size)			
(5) screen <u>10 FT.</u> , <u>294 FT.</u> (length) (depth to top)			
<u>2 inch</u> , <u>S.S.</u> (size) (material)			
(6) pump <u>1</u> <u>8</u> (HP) (yield gpm)			
<u>Elect.</u> (type power)			
(7) electric log <u>No</u> (yes or no)			
(organization running log)			
(8) how well bottom plugged <u>Ball Check</u>			
DRILLERS REMARKS:			

If well telescopes please sketch and show depths.

GROUND LEVEL

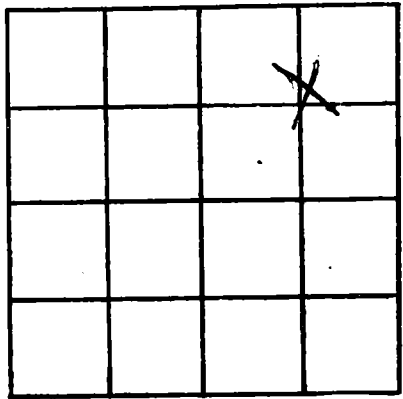

SECTION 4

Please indicate well location X.

ADDITIONAL INFORMATION

If more than one screen, show locations of each on sketch.