

**HARRISON**  
**B47**  
**7-18-72**

MISSISSIPPI  
 BOARD OF WATER COMMISSIONERS  
 416 North State Street  
 Jackson, Mississippi 39201

WATER WELL DRILLERS LOG


**COPIED**

July 18 1972 Ladwiers Well Works HARRISON  
 date well completed firm name county well located

LANDOWNER: <u>Mr. Virgil Showe</u>	description of formations encountered	from	to
<u>Saucier, Miss.</u> (mailing address)	<u>Red Clay</u>	<u>0</u>	<u>150</u>
WELL LOCATION:	<u>Red Sand</u>	<u>150</u>	<u>190</u>
sec. <u>4 T. 5 S.</u> R. <u>12 E.</u> <u>4</u> miles <u>West</u> of <u>Saucier</u> (distance) (direction) (nearest town)	<u>Blue Clay</u>	<u>190</u>	<u>250</u>
WELL PURPOSE: <u>Home</u> (home, irrigation, municipal, industrial)	<u>Blue Sand</u>	<u>250</u>	<u>300</u>
WELL COMPLETION DATA:	<b>COPIED</b>		
(1) diameter (inches) <u>4 inch</u>			
(2) total depth (feet) <u>310 ft.</u>			
(3) static water level (feet) <u>45</u> below top of ground.			
(4) casing <u>Plastic</u> , <u>300ft.</u> (material) (depth)			
<u>4 inch</u> If telescope see back. (size)			
(5) screen <u>10ft.</u> , <u>300ft.</u> (length) (depth to top)			
<u>4 inch</u> , <u>S.S.</u> (size) (material)			
(6) pump <u>1</u> <u>Subsided</u> pump <u>30</u> (HP) (yield gpm)			
<u>Elect.</u> (type power)			
(7) electric log <u>No</u> (yes or no)			
(organization running log)			
(8) how well bottom plugged <u>Ball Check</u>			
DRILLERS REMARKS:	NOV 22 1972 MISS. DIV. OF WATER RESOURCES		

If well telescopes please sketch and show depths.

GROUND LEVEL

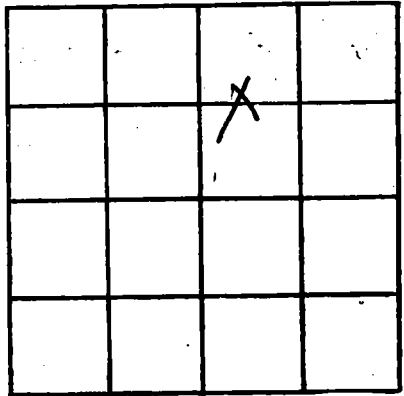

SECTION 4

Please indicate well location X.

ADDITIONAL INFORMATION

If more than one screen, show locations of each on sketch.