

HARRISON
B 48
11-9-72

MISSISSIPPI
 BOARD OF WATER COMMISSIONERS
 416 North State Street
 Jackson, Mississippi 39201

CODED

WATER WELL DRILLERS LOG

Nov 9 1972 M+B Drilling Co. Harrison
 date well completed firm name county well located

LANDOWNER: James Hogan

description of formations encountered

from to

PT. 1
Saucier, Miss.
 (mailing address)

description of formations encountered	from	to
Surface	0	6
Sand	6	33
White Clay	33	75
Sand	75	80
Blue Clay	80	110
Sand	110	115
Blue Clay Blue Clay	115	210
Fine Sand	210	225
Blue Clay	225	251
Sand	251	260
Blue Clay	260	290
Fine Sand	290	305
Blue Clay	305	320
Sand	320	335
Blue Clay	335	374
Fine Powder Sand	374	395
Coarse Sand	395	424
Blue Clay	420	430
		+

CODED

WELL LOCATION:
 sec. 36 T. 5 S. R. 12
1 miles W of Wortham
 (distance) (direction) (nearest town)

WELL PURPOSE: Home
 (home, irrigation, municipal, industrial)

WELL COMPLETION DATA:

- (1) diameter (inches) 2
- (2) total depth (feet) 430
- (3) static water level (feet) 48 below top of ground.
- (4) casing PVC Total
 (material) (depth)
- 2"
 (size) If telescope see back.
- (5) screen 10 FT 4 1/4
 (length) (depth to top)
- 2" PVC 010
 (size) (material)
- (6) pump 1 8 gpm
 (HP) (yield gpm)
- 220 V 1P
 (type power)
- (7) electric log No
 (yes or no)


(organization running log)

(8) how well bottom plugged 2" PVC Cap.

DRILLERS REMARKS:

If well telescopes please sketch and show depths.

GROUND LEVEL

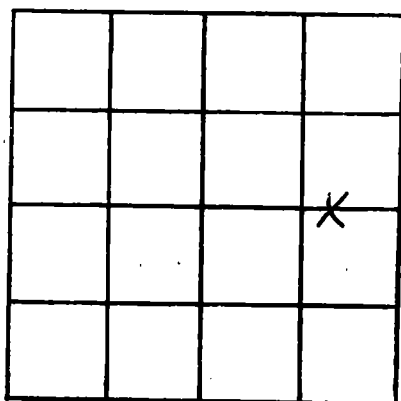

SECTION 35

Please indicate well location X.

ADDITIONAL INFORMATION

If more than one screen,
show locations of each on sketch.