

HARRISON
B 49
3-30-72

MISSISSIPPI
BOARD OF WATER COMMISSIONERS
416 North State Street
Jackson, Mississippi 39201

CODED

WATER WELL DRILLERS LOG

3-30 1972 Parnell Anderson Harrison
date well completed firm name county well located

LANDOWNER: Edd Anderson

Saucier Miss

(mailing address)

WELL LOCATION:

sec. 26 T. 5 N. R. 12 W.
S. W.
12 miles S-W of Saucier
(distance) (direction) (nearest town)

WELL PURPOSE: Home
(home, irrigation, municipal, industrial)

WELL COMPLETION DATA:

- (1) diameter (inches) 2
- (2) total depth (feet) 230
- (3) static water level (feet) 21 below above top of ground.
- (4) casing Plastic, 225'
(material) (depth)

_____ If telescope see back.
(size)

- (5) screen 5', 225'
(length) (depth to top)

2", Plastic
(size) (material)

- (6) pump 1/2, 8
(HP) (yield gpm)

Flect
(type power)

- (7) electric log _____
(yes or no)

_____ (organization running log)

- (8) how well bottom plugged Back Wash Valve

DRILLERS REMARKS:


description of formations encountered	from	to
Top Soil	0	3
Sandy Clay	3	15
Sand & Grav	15	21
Blue Clay	21	164
Fine Sand	164	188
Blue Clay	188	203
Coarse Sand	203	230

CODED

REC 27 2072

If well telescopes please sketch and show depths.

GROUND LEVEL

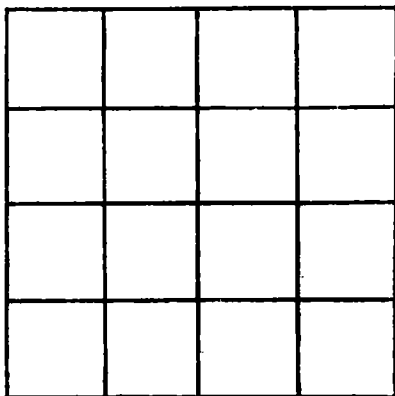

SECTION _____

Please indicate well location X.

ADDITIONAL INFORMATION

If more than one screen, show locations of each on sketch.