

**HARRISON**  
**B 50**  
**1-24-73**

MISSISSIPPI  
 BOARD OF WATER COMMISSIONERS  
 416 North State Street  
 Jackson, Mississippi 39201

**CODED**

**WATER WELL DRILLERS LOG**

1-24 1973 Switzer Well Company Harrison  
 date well completed firm name county well located

LANDOWNER: Sherwood Goff  
Rt 1  
Lauderdale, Miss.  
 (mailing address)

WELL LOCATION:  
 sec. 15 T 5 S R 12 W  
 (distance) miles \_\_\_\_\_ of \_\_\_\_\_ (direction) (nearest town)

WELL PURPOSE: home  
 (home, irrigation, municipal, industrial)

WELL COMPLETION DATA:

- (1) diameter (inches) 2"
- (2) total depth (feet) 321'
- (3) static water level (feet) 38' <sup>below</sup>/<sub>above</sub> top of ground.
- (4) casing galv. 321'  
 (material) (depth)  
 \_\_\_\_\_ if telescope see back.  
 (size)
- (5) screen 10' 311  
 (length) (depth to top)  
008 stainless steel  
 (size) (material)
- (6) pump 1 6  
 (HP) (yield gpm)  
electric  
 (type power)
- (7) electric log No  
 (yes or no)  
 \_\_\_\_\_  
 (organization running log)
- (8) how well bottom plugged back  
pressure valve

description of formations encountered	from	to
Clay	0	66
Clay-sand str.	66	87
Clay	87	129
Clay-sand str.	129	150
Sand	150	162
Clay	162	192
Sand	192	196
Clay	196	208
Sand, fine	208	236
fine sand-clay mix	236	257
fine sand	257	278
good sand	278	321


**CODED**

FEB 15 1973

DRILLERS REMARKS:

If well telescopes please sketch and show depths.

GROUND LEVEL

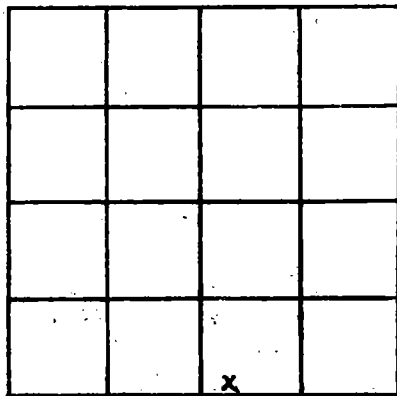

SECTION 15

Please indicate well location X.

ADDITIONAL INFORMATION

If more than one screen, show locations of each on sketch.