

HARRISON
B 63
3-10-74

MISSISSIPPI
BOARD OF WATER COMMISSIONERS
 416 North State Street
 Jackson, Mississippi 39201


WATER WELL DRILLERS LOG

3-10-74 19 74 R. J. Mooker HARRISON
 date well completed firm name county well located

LANDOWNER: <u>Huey McPhen</u> <u>YANKEE TOWN RD</u>	description of formations encountered	from	to
SAUCKER MLS S (mailing address)	TOP SOIL white clay	0	10
WELL LOCATION: sec. <u>14 T 5 N R 12 E</u> <u>2 1/2</u> miles <u>SW</u> of <u>SAUCKER</u> (distance) (direction) (nearest town)	TOP SAND Blue clay	10	20
WELL PURPOSE: (home, irrigation, municipal, industrial)	TOP SAND Blue clay	20	25
WELL COMPLETION DATA: (1) diameter (inches) <u>2"</u> (2) total depth (feet) <u>30'</u> (3) static water level (feet) <u>43'</u> ^{below} / _{above} top of ground. (4) casing <u>galv</u> <u>300</u> (material) (depth) <u> </u> if telescope see back. (size) (5) screen <u>10'</u> <u>310'</u> (length) (depth to top) <u>2"</u> <u>SS</u> (size) (material) (6) pump <u>1</u> <u>8</u> (HP) (yield gpm) <u>?</u> (type power) (7) electric log <u> </u> (yes or no) <u> </u> (organization running log) (8) how well bottom plugged <u>cut thru</u>	Blue clay chase sand	25	270
<p>CODED</p>			
DRILLERS REMARKS:			

If well telescopes please sketch and show depths.

GROUND LEVEL

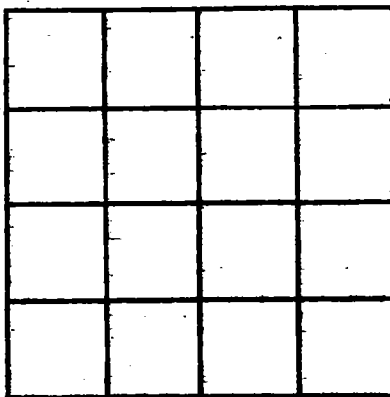

SECTION _____

Please indicate well location X.

ADDITIONAL INFORMATION

A series of horizontal lines for providing additional information, starting below the 'ADDITIONAL INFORMATION' header and extending to the bottom of the page.

If more than one screen, show locations of each on sketch.