

HARRISON

B 64

9-13-73

MISSISSIPPI BOARD OF WATER COMMISSIONERS
416 North State Street
Jackson, Mississippi 39201

WATER WELL DRILLERS LOG

Sept 13 19 73 date well completed
McGill well works firm name
Harrison county well located

LANDOWNER: Oscar Ladner

description of formations encountered

from

to

Pl. 1, Box 393

Lauderdale Miss.
(mailing address)

sand 0 71
blue clay 71 156
slush 156 191
course sand 191 220

WELL LOCATION:

sec 20 T 5 N R 12 E
8 miles S.W. of Lauderdale
(distance) (direction) (nearest town)

WELL PURPOSE: none
(home, irrigation, municipal, industrial)

WELL COMPLETION DATA:

- (1) diameter (inches) 2"
- (2) total depth (feet) 220'
- (3) static water level (feet) 62' below top of ground
- (4) casing gal 210' (material) (depth)
If telescope see back.
- (5) screen 10' (length) (depth to top)
2" (size) S.S. (material)
- (6) pump 1 (HP) 6 (yield gpm)
electric (type power)
- (7) electric log no (yes or no)
(organization running log)
- (8) how well bottom plugged sand shale


CODED

DRILLERS REMARKS:

MISSISSIPPI

If well telescopes please sketch and show depths.

GROUND LEVEL

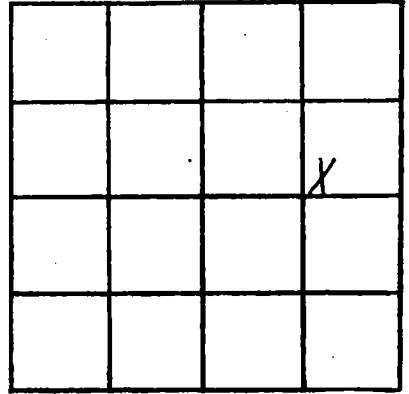

SECTION 20

Please indicate well location X.

ADDITIONAL INFORMATION

If more than one screen,
show locations of each on sketch.