

HARRISON
B 67
7-18-73

MISSISSIPPI
BOARD OF WATER COMMISSIONERS
416 North State Street
Jackson, Mississippi 39201

CODED

WATER WELL DRILLERS LOG

July 18, 1973 H.A. Ladnier's Well Works *Amun*
date well completed firm name county well located

LANDOWNER: Burton Kirby
VANKEE ROAD
SAUCIER, MISS.
(mailing address)

description of formations encountered	from	to
yellow clay	0	90
yellow sand	90	110
yellow clay	110	145
blue clay	145	180
blue sand	180	220

WELL LOCATION:
sec. 4 T. 5 S. R. 12 W.
10 miles SW of Saucier
(distance) (direction) (nearest town)

WELL PURPOSE: HOME
(home, irrigation, municipal, industrial)


- WELL COMPLETION DATA:
- (1) diameter (inches) 2 inch
 - (2) total depth (feet) 220 ft.
 - (3) static water level (feet) 40 ^{below} _{above} top of ground.
 - (4) casing Galv. 210 ft.
(material) (depth)
2 inch if telescope see back.
(size)
 - (5) screen 20 ft. 210 ft.
(length) (depth to top)
2 inch, STAINLESS STEEL
(size) (material)
 - (6) pump 1 8
(HP) (yield gpm)
elec.
(type power)
 - (7) electric log No
(yes or no)
 - (organization running log)
 - (8) how well bottom plugged Ball Check

RECEIVED
NOV - 4 1974

DRILLERS REMARKS:

If well telescopes please sketch and show depths.

GROUND LEVEL

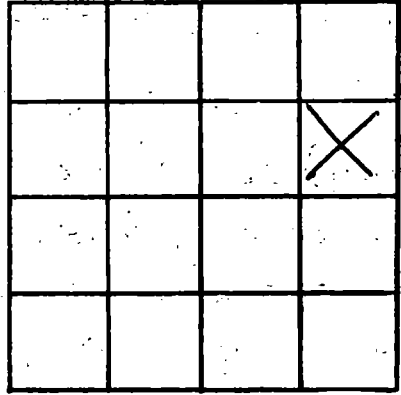

SECTION 4

Please indicate well location X.

ADDITIONAL INFORMATION

If more than one screen, show locations of each on sketch.