

Harrison
B68
3-14-74

MISSISSIPPI
BOARD OF WATER COMMISSIONERS CODED
416 North State Street
Jackson, Mississippi 39201

WATER WELL DRILLERS LOG

March 14 1974 H.A. Laddier Well Works Harrison
date well completed firm name county well located

LANDOWNER: <u>Lowell Kooble</u>	description of formations encountered	from	to
<u>YANKEE ROAD</u> <u>Saucier Miss.</u> (mailing address)			
WELL LOCATION: sec. <u>4</u> T. <u>5</u> S. R. <u>12</u> W. <u>1/4</u> miles <u>SW</u> of <u>Saucier</u> (distance) (direction) (nearest town)	<u>yellow clay</u>	<u>0</u>	<u>35</u>
WELL PURPOSE: <u>HOME</u> (home, irrigation, municipal, industrial)	<u>yellow sand</u>	<u>35</u>	<u>70</u>
WELL COMPLETION DATA: (1) diameter (inches) <u>2 inch</u>	<u>yellow clay</u>	<u>70</u>	<u>110</u>
(2) total depth (feet) <u>241 FT.</u>	<u>blue clay</u>	<u>110</u>	<u>195</u>
(3) static water level (feet) <u>18</u> below top of ground.	<u>blue sand</u>	<u>195</u>	<u>241</u>
(4) casing <u>Galv.</u> <u>231ft.</u> (material) (depth)			
<u>2 inch</u> if telescope see back. (size)			
(5) screen <u>10 ft.</u> <u>231ft.</u> (length) (depth to top)			
<u>2 inch</u> <u>SS STEEL</u> (size) (material)			
(6) pump <u>1</u> <u>8</u> (HP) (yield gpm)			
<u>Electric</u> (type power)			
(7) electric log <u>NO</u> (yes or no)			
(organization running log)			
(8) how well bottom plugged <u>Ball Check</u>			
DRILLERS REMARKS:			


RECEIVED

NOV - 4 1974

MISS. BD. OF WATER COMM

If well telescopes please sketch and show depths.

GROUND LEVEL

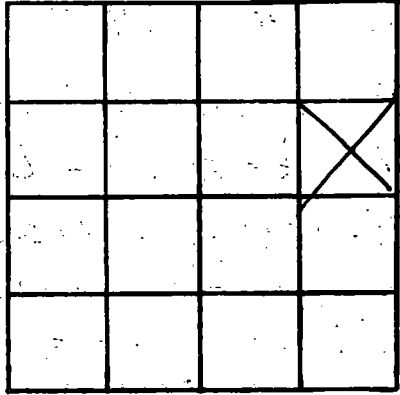

SECTION 4

Please indicate well location X.

ADDITIONAL INFORMATION

If more than one screen, show locations of each on sketch.