

Harrison
B 70
2-9-74

MISSISSIPPI
 BOARD OF WATER COMMISSIONERS **CODED**
 416 North State Street
 Jackson, Mississippi 39201

WATER WELL DRILLERS LOG

Feb. 9 19 74 McGill well works Harrison
 date well completed firm name county well located

LANDOWNER: Jay Allison
Rt. 1, Box 572
Saucier Miss
 (mailing address)

WELL LOCATION:
 sec 12 T 5 N R 12 E
3 miles S of Saucier
 (distance) (direction) (nearest town)

WELL PURPOSE: Home
 (home, irrigation, municipal, industrial)

WELL COMPLETION DATA:
 (1) diameter (inches) 2"
 (2) total depth (feet) 750"
 (3) static water level (feet) 65 below above
 top of ground.
 (4) casing PVC, 730'
 (material) (depth)
 (size) If telescope see back.
 (5) screen 20" —
 (length) (depth to top)
2" 5.5'
 (size) (material)
 (6) pump 1 12
 (HP) (yield gpm)
Electric
 (type power)
 (7) electric log NO
 (yes or no)
 (organization running log)

(8) how well bottom plugged Sand
stark - back wash valve

description of formations encountered	from	to
Clay	0	20
sand	20	83
Clay	83	98
slush	98	147
blue clay	147	210
slush	210	245
fine sand	245	294
blue clay	294	352
CODED	352	389
slush	389	420
blue clay	420	481
slush	481	513
sand	513	568
blue clay	568	622
slush	622	677
slay	677	708
course	708	750


DISCONTINUED

JAN 21 1975

DRILLERS REMARKS:

If well telescopes please sketch and show depths.

GROUND LEVEL

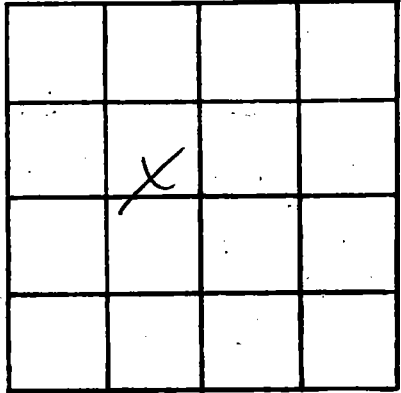

SECTION 12

Please indicate well location X.

ADDITIONAL INFORMATION

If more than one screen, show locations of each on sketch.