

Harrison  
 B 72  
 6/14/79

MISSISSIPPI  
 BOARD OF WATER COMMISSIONERS  
 416 North State Street  
 Jackson, Mississippi 39201

CODED

WATER WELL DRILLERS LOG

6/14/1979 Lyman Well Harrison  
 date well completed firm name county well located

LANDOWNER: Mr. N. Wood  
2 Yankee Town Rd  
Saucier Miss  
 (mailing address)

| description of formations encountered | from | to  |
|---------------------------------------|------|-----|
| yellow clay                           | 0    | 6   |
| white clay                            | 6    | 40  |
| sand                                  | 40   | 60  |
| grayed blue clay                      | 60   | 260 |
| o. sand                               | 260  | 301 |

WELL LOCATION:  
 sec. 15 T. 5 N R. 12 E  
3 miles SW of Saucier  
 (distance) (direction) (nearest town)

WELL PURPOSE: Home  
 (home, irrigation, municipal, industrial)

- WELL COMPLETION DATA:
- (1) diameter (inches) 4x2
  - (2) total depth (feet) 301
  - (3) static water level (feet) 40 below above top of ground.
  - (4) casing PVC 301  
 (material) (depth)  
4x2 If telescope see back.  
 (size)
  - (5) screen 10' 290  
 (length) (depth to top)  
8 slot PVC  
 (size) (material)
  - (6) pump 1 25  
 (HP) (yield gpm)  
 (type power)
  - (7) electric log NO  
 (yes or no)  
 (organization running log)
  - (8) how well bottom plugged Back drilled

Miss. Board of Water Comm.


JUL 9 1979

RECEIVED

DRILLERS REMARKS:

If well telescopes, please sketch and show depths.

GROUND LEVEL

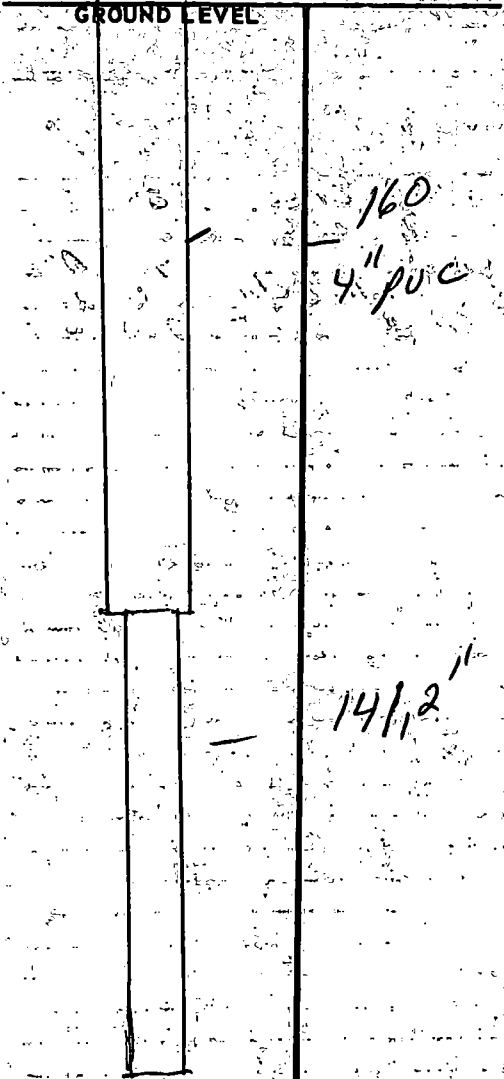

|  |  |   |  |
|--|--|---|--|
|  |  |   |  |
|  |  | X |  |
|  |  |   |  |
|  |  |   |  |

SECTION 15

Please indicate well location X.

**ADDITIONAL INFORMATION**

---

---

If more than one screen, show locations of each on sketch.