

Harrison
 B 73
 8-29-79

MISSISSIPPI
 BOARD OF WATER COMMISSIONERS
 416 North State Street
 Jackson, Mississippi 39201

CODED

WATER WELL DRILLERS LOG

8-29 1979 Braden Pump + Harrison
 date well completed firm name county well located
 well log done

LANDOWNER:
 William Touchette
 Rt. 1, Box 152
 Saucier, MS
 (mailing address)

description of formations encountered	from	to
Clay	0	100
Sands	100	110
Clay	110	260
Sand	260	300

WELL LOCATION:
 sec. 14 T. 5 N R. 12 E
 S W
 2 miles SW of Saucier
 (distance) (direction) (nearest town)

CODED

WELL PURPOSE: None
 (home, irrigation, municipal, industrial)

WELL COMPLETION DATA:
 (1) diameter (inches) 4" x 2"
 (2) total depth (feet) 320'
 (3) static water level (feet) 60' below above top of ground.
 (4) casing PVC, total, (material) (depth)
4" x 2" If telescope see back. (size)
 (5) screen 15', 305' (length) (depth to top)
2', 008 PVC underdrain (size) (material)
 (6) pump 1 1/2 20 (HP) (yield gpm)
270V 1Ø (type power)
 (7) electric log NO (yes or no)
 (organization running log)
 (8) how well bottom plugged 2" sand wash

DEPT. OF NATURAL RESOURCES
 BUREAU OF LAND & WATER RESOURCES


OCT 16 1979

RECEIVED

DRILLERS REMARKS:
 no tail pipe

If well telescopes please sketch and show depths.

GROUND LEVEL

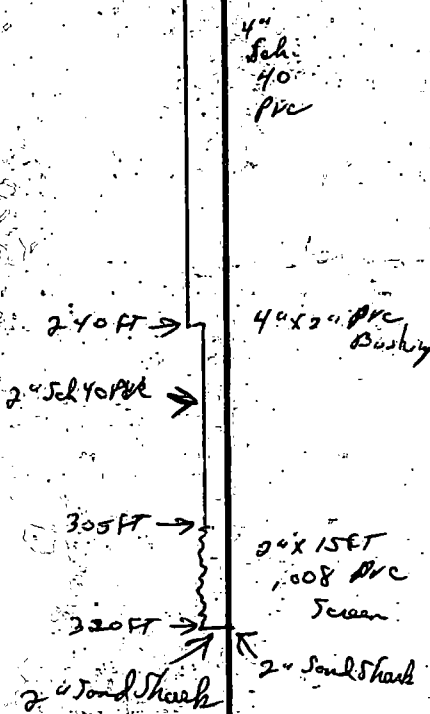

	X		

SECTION 14

Please indicate well location X.

ADDITIONAL INFORMATION

If more than one screen, show locations of each on sketch.