

MISSISSIPPI
BOARD OF WATER COMMISSIONERS
416 North State Street
Jackson, Mississippi 39201

CODED

WATER WELL DRILLERS LOG

COASTAL DRILLING & SERVICE CO. ~~CODED~~

ROUTE 1 BOX 618

county well located

Harrison
B # B7
1-27-75

1/27 1975
date well completed

LANDOWNER: M. T. K... MISS.

Rt 5
apt. 0015
(mailing address)

WELL LOCATION:
sec 23 T S N R 12 E 135 W

(3) Three miles NW of Worham
(distance) (direction) (nearest town)

WELL PURPOSE: home
(home, irrigation, municipal, industrial)

WELL COMPLETION DATA:

- (1) diameter (inches) 2"
- (2) total depth (feet) 225'
- (3) static water level (feet) 25' below top of ground
- (4) casing P.C. 265'
(material) (depth)
- (5) screen 10' 265'
(length) (depth to top)
- 2"
(size) P.C.
(material)
- (6) pump one 15
(HP) (yield gpm)
- Ele
(type power)
- (7) electric log no
(yes or no)


(organization running log)

(8) how well bottom plugged
2" back wash valve

DRILLERS REMARKS:


description of formations encountered	from	to
Top Soil	1	3
Red Clay	3	18
White Sand	18	25
Soft Clay	25	65
Hard Clay	65	120
fine water sand	120	138
hard clay	138	220
fine water sand	220	240
hard water sand	240	275

~~CODED~~
CODED

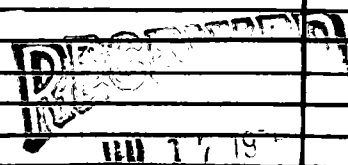

If well telescopes please sketch and show depths.

GROUND LEVEL

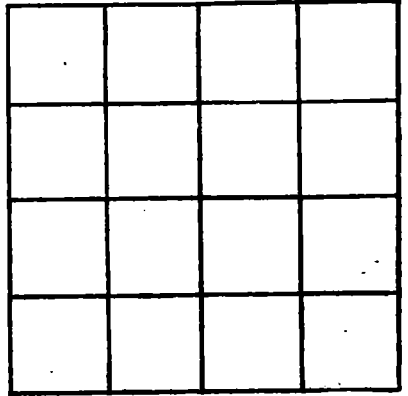

SECTION _____

Please indicate well location X.

ADDITIONAL INFORMATION

Lined area for providing additional information.

If more than one screen, show locations of each on sketch.