

Harrison
 B 79
 7-30-75

MISSISSIPPI
 BOARD OF WATER COMMISSIONERS
 416 North State Street
 Jackson, Mississippi 39201

CODED

WATER WELL DRILLERS LOG

7-30-1975 McGee Well Works Harrison
 date well completed firm name county well located

LANDOWNER: <u>Allen Parker</u> <u>1901 Switzer Rd.</u> <u>Opelousas, MS.</u> (mailing address)	description of formations encountered	from	to
	Red sand	0	42
	White clay	42	138
	fine sand	138	189
	bluish	189	228
	Blue clay	228	267
	fine sand	267	296
	Colored sand	296	337

WELL LOCATION:
 sec. 10 T. 3 N. R. 12 E. ¹³⁵
4 miles SW of Soullard
 (distance) (direction) (nearest town)

WELL PURPOSE: Home
 (home, irrigation, municipal, industrial)

WELL COMPLETION DATA:

(1) diameter (inches) 2"

(2) total depth (feet) 337'

(3) static water level (feet) 78' ^{below} above top of ground.

(4) casing plastic 327'
 (material) (depth)

(size) If telescope see back.

(5) screen 10' —
 (length) (depth to top)

2" 3.5
 (size) (material)

(6) pump 1 7
 (HP) (yield gpm)

electric
 (type power)


(7) electric log NO
 (yes or no)

(organization running log)

(8) how well bottom plugged sand
shark

DRILLERS REMARKS:

CODED

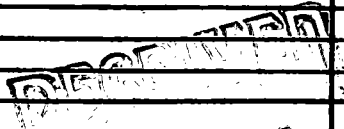


NOV 23 1975

MISS. BD. OF WATER COMM

If well telescopes please sketch and show depths.

GROUND LEVEL

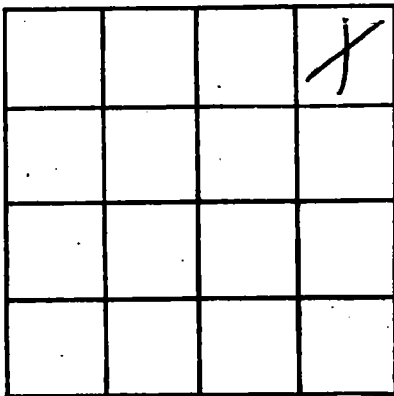

SECTION 10

Please indicate well location X.

ADDITIONAL INFORMATION

If more than one screen, show locations of each on sketch.