

Harrison  
 B 80  
 9-6-75

MISSISSIPPI  
 BOARD OF WATER COMMISSIONERS  
 416 North State Street  
 Jackson, Mississippi 39201

CODED

WATER WELL DRILLERS LOG


Sept. 6 1975 Mc Hill Well Works Harrison  
 date well completed firm name county well located

LANDOWNER: <u>Wheeler Parker</u>		description of formations encountered	from	to
<u>Rt. 1, Box 120</u>				
<u>Lucier, Miss.</u> (mailing address)		<u>Clay</u>	<u>0</u>	<u>67</u>
		<u>Sand</u>	<u>67</u>	<u>91</u>
		<u>Slush</u>	<u>91</u>	<u>128</u>
WELL LOCATION: sec <u>3</u> T <u>S</u> N R <u>12</u> <u>135</u> <u>W</u> of <u>Lucier</u>		<u>Blue Clay</u>	<u>128</u>	<u>157</u>
<u>3 1/2</u> miles (distance) <u>W</u> (direction) (nearest town)		<u>Blue Sand</u>	<u>157</u>	<u>189</u>
WELL PURPOSE: <u>None</u> (home, irrigation, municipal, industrial)		<u>Blue Clay</u>	<u>189</u>	<u>231</u>
WELL COMPLETION DATA: (1) diameter (inches) <u>2"</u>		<u>Slush</u>	<u>231</u>	<u>262</u>
(2) total depth (feet) <u>317'</u>		<u>Blue Clay</u>	<u>262</u>	<u>281</u>
(3) static water level (feet) <u>20'</u> <u>below</u> above top of ground.		<u>Course Sand</u>	<u>281</u>	<u>317</u>
(4) casing <u>plastic</u> <u>307</u> (material) (depth)				
(size) If telescope see back.				
(5) screen <u>10'</u> (length) (depth to top)				
<u>2"</u> (size) <u>5.5'</u> (material)				
(6) pump <u>1</u> (HP) <u>8</u> (yield gpm)				
<u>electric</u> (type power)				
(7) electric log <u>no</u> (yes or no)				
(organization running log)				
(8) how well bottom plugged <u>sand</u> <u>shark</u>				
DRILLERS REMARKS:				

CODED

If well telescopes please sketch and show depths.

GROUND LEVEL

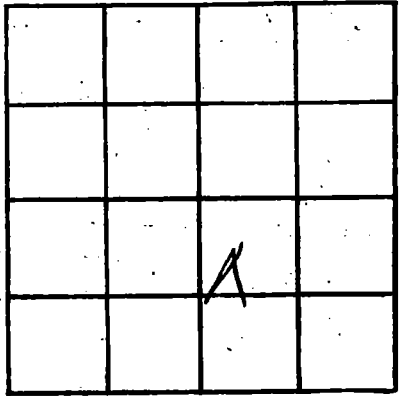

SECTION 3

Please indicate well location X.

ADDITIONAL INFORMATION

If more than one screen, show locations of each on sketch.