

Harrison
B 81
9-30-75

MISSISSIPPI
 BOARD OF WATER COMMISSIONERS
 416 North State Street
 Jackson, Mississippi 39201

CODED

WATER WELL DRILLERS LOG

Sept. 30 19 75 McHill Well Works Harrison
 date well completed firm name county well located

LANDOWNER: William Infield
Route 2
Yuleport Miss.
 (mailing address)

WELL LOCATION:
 sec. 14 5 N 12 E 135
6 miles W of Jaucies
 (distance) (direction) (nearest town)

WELL PURPOSE: home
 (home, irrigation, municipal, industrial)

WELL COMPLETION DATA:

(1) diameter (inches) 2"

(2) total depth (feet) 336'

(3) static water level (feet) 40' below above top of ground.

(4) casing plastic, 336'
 (material) (depth)

— (size) if telescope see back.

(5) screen 10', —
 (length) (depth to top)

2", 5.5
 (size) (material)

(6) pump 1, 7
 (HP) (yield gpm)

electric
 (type power)

(7) electric log no
 (yes or no)

—
 (organization running log)

(8) how well bottom plugged sand
shark

description of formations encountered	from	to
clay	0	21
Gravel	21	42
sand	42	63
G. sand	63	87
clay	87	105
Sand N. of McHill	105	126
clay	126	147
clay	147	168
clay	168	231
C. sand	231	336


CODED

DRILLERS REMARKS:

RECORDED
 INDEXED
 OCT 20 1975
 RECEIVED

If well telescopes please sketch and show depths.

GROUND LEVEL

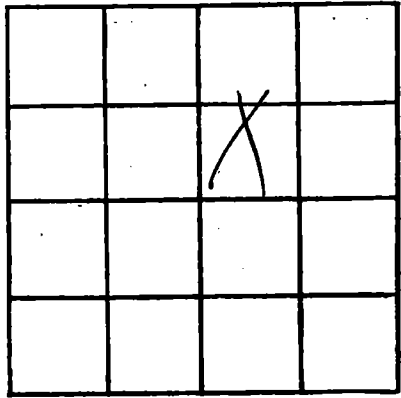

SECTION 10

Please indicate well location X.

ADDITIONAL INFORMATION

If more than one screen, show locations of each on sketch.