

Harrison  
B 82  
10-20-75

MISSISSIPPI  
 BOARD OF WATER COMMISSIONERS  
 416 North State Street  
 Jackson, Mississippi 39201

CODED

WATER WELL DRILLERS LOG

Oct 20 1975 McGil well works Harrison  
 date well completed firm name county well located

LANDOWNER: George Whalley  
1208 43rd. AVE  
Sheppard, Mo.  
 (mailing address)

WELL LOCATION:  
 sec. 2 T. 5 N. R. 12 E. <sup>13S</sup>  
#2 miles NW of Taucer  
 (distance) (direction) (nearest town)

WELL PURPOSE: home  
 (home, irrigation, municipal, industrial)

WELL COMPLETION DATA:

(1) diameter (inches) 2"

(2) total depth (feet) 294'

(3) static water level (feet) 75' <sup>below</sup> <sub>above</sub> top of ground.

(4) casing plastic, 284'  
 (material) (depth)

— If telescope see back.  
 (size)

(5) screen 10 (length) (depth to top)  
2" (size) 5.5 (material)

(6) pump 1 (HP) 8 (yield gpm)  
Electric (type power)


(7) electric log no (yes or no)

— (organization running log)

(8) how well bottom plugged sand  
shank

description of formations encountered	from	to
clay	0	25
Red Sand	25	68
slush	68	93
White clay	93	127
fine sand	127	161
Blue clay	161	261
slush	261	278
Blue clay	278	294
Coarse sand	294	

CODED

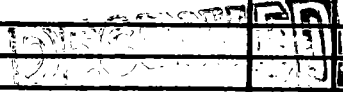

NOV 28 1975

MISS. BD. OF WATER COMMISSIONERS

DRILLERS REMARKS:

