

Harrison  
 B 83  
 10-31-75

MISSISSIPPI  
 BOARD OF WATER COMMISSIONERS  
 416 North State Street  
 Jackson, Mississippi 39201

WATER WELL DRILLERS LOG

CODED

10-31-75 date well completed  
 Panell Anderson firm name  
 Harrison county well located


LANDOWNER:	description of formations encountered	from	to
Arnold Smith			
(mailing address)	Red Clay	3	16
WELL LOCATION:	White Clay	16	38
sec. 10 T. 6 N. R. 12 E. 13 S.	Blue Clay	38	85
2 miles SW of Jackson	Fine Sand	85	96
(distance) (direction) (nearest town)	Coarse Sand	96	103
WELL PURPOSE: HOME			
(home, irrigation, municipal, industrial)			
WELL COMPLETION DATA:			
(1) diameter (inches) 2"			
(2) total depth (feet) 103'			
(3) static water level (feet) 45" below top of ground			
(4) casing (material) Plastic (depth) 98'			
(size) if telescope see back.			
(5) screen (length) 15' (depth to top) 98'			
(size) (material) 2" Plastic			
(6) pump (HP) 1 (yield gpm) 9			
(type power) Elect			
(7) electric log no (yes or no)			
(organization running log)			
(8) how well bottom plugged Plugged			
DRILLERS REMARKS:			

CODED

NOV 5 1975  
 MISS. BU. OF WATER COMM.

If well telescopes please sketch and show depths.

GROUND LEVEL

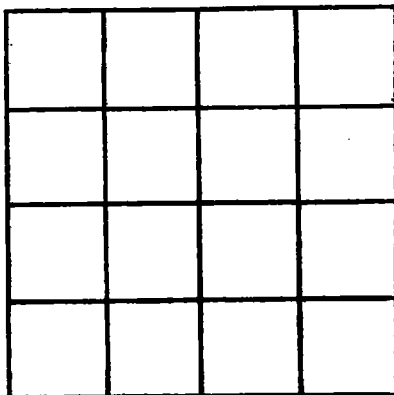

SECTION \_\_\_\_\_

Please indicate well location X.

ADDITIONAL INFORMATION

A series of horizontal lines for recording additional information, starting below the 'ADDITIONAL INFORMATION' header and extending to the bottom of the page.

If more than one screen, show locations of each on sketch.