

HARRISON
B 84
2-6-76

MISSISSIPPI
BOARD OF WATER COMMISSIONERS
416 North State Street
Jackson, Mississippi 39201

CODED

WATER WELL DRILLERS LOG
COASTAL DRILLING & SERVICE CO.

2/6/76 19 date well completed
ROUTE 1 BOX 618 name
Biloxi, Miss. 39532 county well located Harrison

LANDOWNER: Norman Planner
Rt 5
Saucier, Miss
(mailing address)

description of formations encountered	from	to
Top Soil	1	3
Red Soft Clay	3	15
White Sand	15	45
Sugar Sand	45	60
Soft White Clay	60	80
Coarse white Sand	80	100
Soft Blue Clay	100	240
fine water sand	240	270
Hard Blue Clay	270	300
fine water sand	300	310
fine water sand	310	330

WELL LOCATION:
sec. 2 T. 5 N. R. 12 E.
S W
2 1/2 miles W Saucier of (nearest town)

WELL PURPOSE: home
(home, irrigation, municipal, industrial)

WELL COMPLETION DATA:
(1) diameter (inches) 2"
(2) total depth (feet) 340'
(3) static water level (feet) 80 below top of ground.
(4) casing PVC 330' (material) (depth)
(size) if telescope see back.
(5) screen 10' 330' (length) (depth to top)
2" PVC (size) (material)
(6) pump 1/2 10 (HP) (yield gpm)
Ele (type power)
(7) electric log no (yes or no)
(organization running log)

CODED


(8) how well bottom plugged
2" hard wood & blue

DRILLERS REMARKS:
None

MAR 27 1976

If well telescopes please sketch and show depths.

GROUND LEVEL

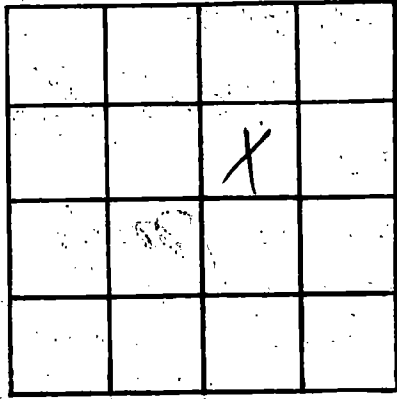

SECTION _____

Please indicate well location X.

ADDITIONAL INFORMATION

Lined area for additional information.

If more than one screen, show locations of each on sketch.