

HARRISON
 B 85
 2-13-76

MISSISSIPPI
 BOARD OF WATER COMMISSIONERS
 416 North State Street
 Jackson, Mississippi 39201

CODED

WATER WELL DRILLERS LOG

2-13-76 date well completed
 76 Pamell Anderson firm name
 Harrison county well located

LANDOWNER:
Louis J. Linnors
 (mailing address)

WELL LOCATION:
 sec. 3 T. 5 R. 12
3 miles W of Saunder
 (distance) (direction) (nearest town)


WELL PURPOSE: HOME
 (home, irrigation, municipal, industrial)

- WELL COMPLETION DATA:
- (1) diameter (inches) 2"
 - (2) total depth (feet) 74'
 - (3) static water level (feet) 18' below above top of ground.
 - (4) casing Plastic 6 9'
 (material) (depth)
 (size) If telescope see back.
 - (5) screen 5' 6 9'
 (length) (depth to top)
2" Plastic
 (size) (material)
 - (6) pump 1 12
 (HP) (yield gpm)
Elect
 (type power)
 - (7) electric log no
 (yes or no)
 - (organization running log)
 - (8) how well bottom plugged
Capped

description of formations encountered	from	to
<u>Top Soil</u>	<u>0</u>	<u>4</u>
<u>Coarse Sand</u>	<u>4</u>	<u>4.5</u>
<u>Clay</u>	<u>4.5</u>	<u>5.4</u>
<u>Coarse Sand</u>	<u>5.4</u>	<u>7.4</u>

CODED

DRILLERS REMARKS:

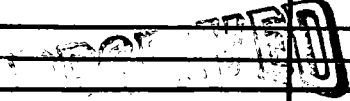


MAR 3 1976

MISS. BD. OF WATER COMM

If well telescopes please sketch and show depths.

GROUND LEVEL

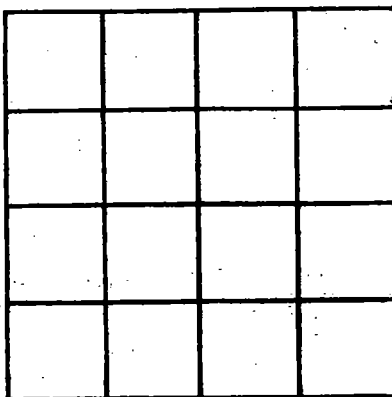

SECTION _____

Please indicate well location X.

ADDITIONAL INFORMATION

If more than one screen, show locations of each on sketch.