

HARRISON
B 87
8-11-77

MISSISSIPPI
BOARD OF WATER COMMISSIONERS
416 North State Street
Jackson, Mississippi 39201

CODED

WATER WELL DRILLERS LOG

8-11-77 date well completed
1977 Fane Andersen firm name
Harrison county well located

LANDOWNER:
Richard Ladines
(mailing address)

description of formations encountered	from	to
Top Soil	0	2
Course Sand	2	36
Blue Clay	36	180
Fine Sand	180	206
Blue Clay	206	220
Clay + Sand Strata	220	322

WELL LOCATION:
sec. 22 T. 5 S. R. 12 E.
3 miles W of Sauls
(distance) (direction) (nearest town)

WELL PURPOSE: HOME
(home, irrigation, municipal, industrial)

WELL COMPLETION DATA:

(1) diameter (inches) 2"
(2) total depth (feet) 322'
(3) static water level (feet) 6' below top of ground
(4) casing Plastic, 317' (material) (depth)
(size) If telescope see back.
(5) screen 5' length, 317' depth to top
2" (size) Plastic (material)
(6) pump 1 (HP) 13 (yield gpm)
Elect (type power)
(7) electric log No (yes or no)
(organization running log)

(8) how well bottom plugged
Block with valve

DRILLERS REMARKS:


CODED

RECEIVED
SEP - 2 1977

MISS. BD. OF WATER COMM

If well telescopes please sketch and show depths.

GROUND LEVEL

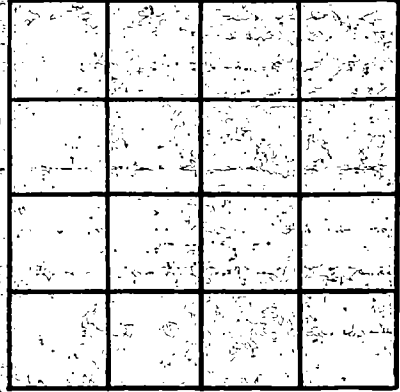

SECTION _____

Please indicate well location X.

ADDITIONAL INFORMATION

If more than one screen, show locations of each on sketch.