

HARRISON
B 88
1/4/78

MISSISSIPPI
BOARD OF WATER COMMISSIONERS
416 North State Street
Jackson, Mississippi 39201

CODED

WATER WELL DRILLERS LOG

Jan 4 1978 Duncan Well Drilling Harrison
date well completed firm name county well located

LANDOWNER: Frank Brown
P.O. Box 1961
Sherrill, MS
Williston, MS (mailing address)
WELL LOCATION:
sec 27 T 4 S R 12 E
3 miles W of Harrison
(distance) (direction) (nearest town)

description of formations encountered	from	to
Clay	0	20
fine sand	20	41
Clay	41	105
fine sand	105	170
course sand	170	200

WELL PURPOSE: Home
(home, irrigation, municipal, industrial)

WELL COMPLETION DATA:
(1) diameter (inches) 4"
(2) total depth (feet) 200
(3) static water level (feet) 65' below top of ground.
(4) casing 4" PVC, 200,
(material) (depth)
 If telescope see back.
(size)
(5) screen 10', 190
(length) (depth to top)
4" x 10" PVC sch. 40
(size) (material)
(6) pump 1 sub., 20
(HP) (yield gpm)
electric
(type power)
(7) electric log
(yes or no)

(organization running log)
(8) how well bottom plugged Sand
Shark

CODED


RECEIVED
JAN 25 1978

DRILLERS REMARKS:

MISS. BD. OF WATER COM.

If well telescopes please sketch and show depths.

GROUND LEVEL

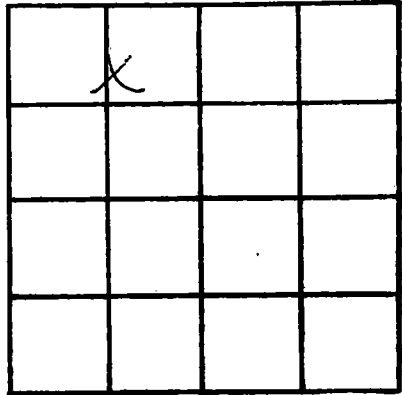

SECTION 27

Please indicate well location X.

ADDITIONAL INFORMATION

Lined area for additional information.

If more than one screen, show locations of each on sketch.