

HARRISON  
B91  
7-1-78

MISSISSIPPI  
BOARD OF WATER COMMISSIONERS  
416 North State Street  
Jackson, Mississippi 39201

CODED

WATER WELL DRILLERS LOG

7-1-78 date well completed 19 Switzer Well Co. firm name Harrison county well located

LANDOWNER: <u>FRANK HENDERSON</u>	description of formations encountered	from	to
<u>YANKER TOWN ROAD</u> (mailing address)	SAND	0	7
	CLAY	7	81
	CLAY WITH SAND STREAKS	81	101
	SAND	101	113
	CLAY	113	214
	SAND	214	222
	CLAY	222	270
	SAND	270	348

WELL LOCATION:  
sec. 25 T 5 N R. 12 E  
3 1/2 miles S of SAUCIER  
(distance) (direction) (nearest town)

WELL PURPOSE: Home  
(home, irrigation, municipal, industrial)

- WELL COMPLETION DATA:
- (1) diameter (inches) 2"
  - (2) total depth (feet) 348'
  - (3) static water level (feet) 43 <sup>below</sup>/<sub>above</sub> top of ground.
  - (4) casing PVC, 328'  
(material), (depth)  
         if telescope see back.  
(size)
  - (5) screen 20', 328'  
(length), (depth to top)  
2", PVC CROWN  
(size), (material)
  - (6) pump 1 12  
(HP), (yield gpm)  
AC  
(type power)
  - (7) electric log NO  
(yes or no)  
          
(organization running log)
  - (8) how well bottom plugged  
METH BACKWASH VALVE

CODED

RECEIVED  
AUG 15 1978


MISS. BD. OF WATER COMM

DRILLERS REMARKS:

If well telescopes please sketch and show depths.

PROVED

GROUND LEVEL

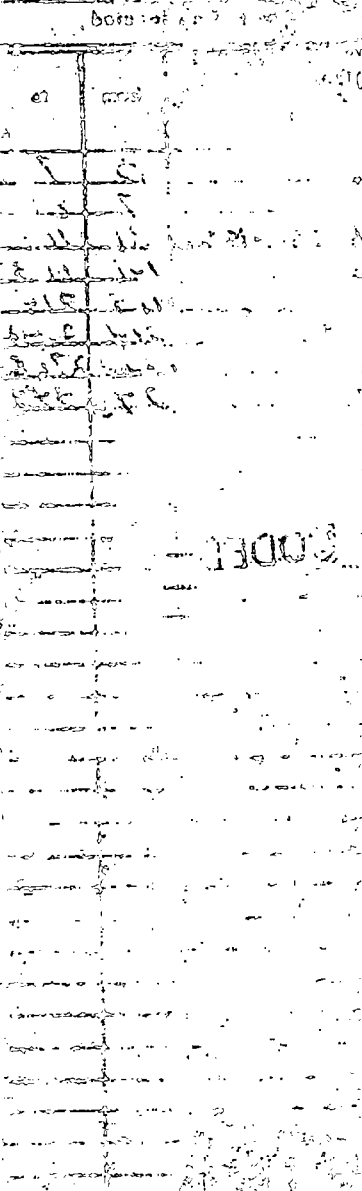

			X

SECTION 15

Please indicate well location X.

ADDITIONAL INFORMATION

Blank lined area for additional information.

If more than one screen, show locations of each on sketch.