

HARRISON
B 92
11-15-78

MISSISSIPPI
 BOARD OF WATER COMMISSIONERS
 416 North State Street
 Jackson, Mississippi 39201

CODED

WATER WELL DRILLERS LOG

11/15 1978 Duncan Well Drilling Harrison
 date well completed firm name county well located

LANDOWNER: Wayne Smith
P.O. Box 234
Sauces, Mo
 (mailing address)

description of formations encountered	from	to
<u>Red Clay</u>	<u>0</u>	<u>20</u>
<u>White clay</u>	<u>20</u>	<u>150</u>
<u>Blue clay</u>	<u>150</u>	<u>245</u>
<u>fine sand</u>	<u>245</u>	<u>275</u>
<u>Course sand</u>	<u>275</u>	<u>295</u>

WELL LOCATION:
 sec 25.5 T 5 N R 1X2 E
3 miles (distance) of Sauces (nearest town)

WELL PURPOSE: Home
 (home, irrigation, municipal, industrial)

WELL COMPLETION DATA:

(1) diameter (inches) 2 1/2

(2) total depth (feet) 295

(3) static water level (feet) 95' below above top of ground.

(4) casing PVC 285
 (material) (depth)

 If telescope see back.
 (size)

(5) screen 10' 285
 (length) (depth to top)

2" PVC
 (size) (material)

(6) pump 1 6
 (HP) (yield gpm)

electric
 (type power)

(7) electric log
 (yes or no)

 (organization running log)

(8) how well bottom plugged sand
shark

CODED

RECEIVED


JAN 10 1978

MISS. BD. OF WATER COMM

DRILLERS REMARKS:

If well telescopes please sketch and show depths.

GROUND LEVEL

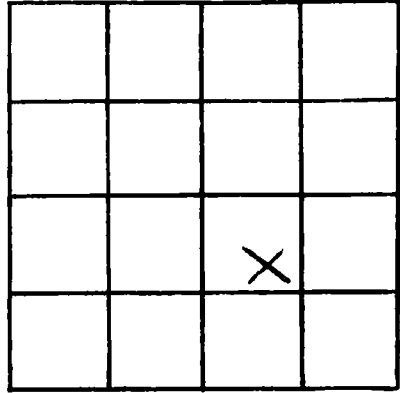

SECTION 25

Please indicate well location X.

ADDITIONAL INFORMATION

If more than one screen,
show locations of each on sketch.