

HARRISON
 B 96
 T-14-78

MISSISSIPPI
 BOARD OF WATER COMMISSIONERS
 416 North State Street
 Jackson, Mississippi 39201

CODED

WATER WELL DRILLERS LOG

July 14 1978 Braden Pumphill Harrison
 date well completed firm name county well located
 Duncan Well Drilling

LANDOWNER: Mr. Hogan
 Wortham Rd.
 Saurier, Ms.
 (mailing address)

WELL LOCATION:
 sec 32 T. 5 N R. 12 E
 8 miles NW of Lyman
 (distance) (direction) (nearest town)

WELL PURPOSE: Home
 (home, irrigation, municipal, industrial)

WELL COMPLETION DATA:
 (1) diameter (inches) 4" x 2"
 (2) total depth (feet) 420'
 (3) static water level (feet) 60' below top of ground.
 (4) casing PVC, 410' (material) (depth)
 (size) if telescope see back.
 (5) screen 10' 410' (length) (depth to top)
 2" PVC sch. 40 (size) (material)
 (6) pump 1/2 sub 15 (HP) (yield gpm)
 electric (type power)
 (7) electric log No. (yes or no)
 (organization running log)
 (8) how well bottom plugged Sand

description of formations encountered	from	to
Red Clay	0	20
Top. Sand	20	50
Blue Clay	50	212
fine sand	212	220
Blue Clay	220	340
fine sand	340	380
Course SAND	380	420

CODED


RECEIVED
 AUG 11 1978

MISS. BD. OF WATER COMM

DRILLERS REMARKS:

If well telescopes please sketch and show depths.

GROUND LEVEL

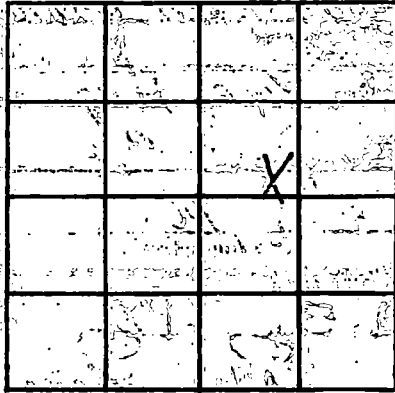

SECTION 32

Please indicate well location X.

ADDITIONAL INFORMATION

Multiple horizontal lines for additional information.

If more than one screen, show locations of each on sketch.