

HARRISON

B 97

8/14/78

MISSISSIPPI BOARD OF WATER COMMISSIONERS
416 North State Street
Jackson, Mississippi 39201

CODED

WATER WELL DRILLERS LOG

8/14/78 date well completed

19

Lyman Well Co. firm name

Harrison county well located

LANDOWNER: Oscar Maxwell

Diamond Road

Saucier, Md

(mailing address)

WELL LOCATION:

sec. 35 T 4 N R 12 E
20 miles S of Wiggins
(distance) (direction) (nearest town)

WELL PURPOSE: home
(home, irrigation, municipal, industrial)

WELL COMPLETION DATA:

- (1) diameter (inches) 4
- (2) total depth (feet) 200
- (3) static water level (feet) 8 ^{below} top of ground
- (4) casing PVC (material), 4 in (size) if telescope see back.
- (5) screen 16' (length), 190 (depth to top), 10 slot (size), PVC (material)
- (6) pump 1 (HP), 16 (yield gpm), 220 (type power)
- (7) electric log No (yes or no)

(organization running log)

(8) how well bottom plugged Sand Shark

description of formations encountered

from to

red clay	0	8
sand & gravel	8	15
red white & gray clay	15	65
SAND salt pepper	65	73
Blue, grey clay	73	145
sand	145	200

CODED

RECEIVED


SEP 11 1978

DRILLERS REMARKS:

MISS. BD. OF WATER COMM

If well telescopes please sketch and show depths.

GROUND LEVEL

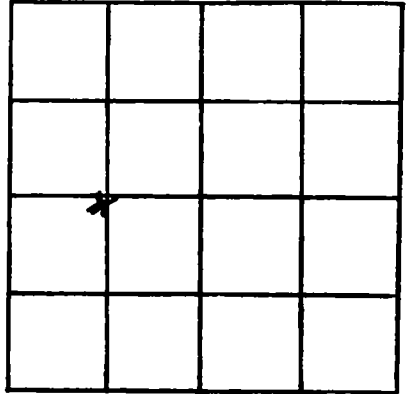

SECTION 35

Please indicate well location X.

ADDITIONAL INFORMATION

Lined area for additional information.

If more than one screen, show locations of each on sketch.