

HARRISON

B 98

8-14-78

MISSISSIPPI BOARD OF WATER COMMISSIONERS CODED 416 North State Street Jackson, Mississippi 39201

WATER WELL DRILLERS LOG

8/14 date well completed 1978 Lyman Well Co firm name Harrison county well located

LANDOWNER: Dennis Mays Saucier Lyana Rd Lyana, MS (mailing address)

Table with 3 columns: description of formations encountered, from, to. Rows include red clay, red sand, red & white clay, orange sand, CLAY GREY, sand & mud dark grey, grey & blue clay, blue grey sand, grey blue clay, salt & pepper sand.


WELL LOCATION: sec 32 T 5 N R 12 E 20 miles NW of Gulfport

WELL PURPOSE: home (home, irrigation, municipal, industrial)

WELL COMPLETION DATA:

- (1) diameter (inches) 2 in
(2) total depth (feet) 400
(3) static water level (feet) 60 below top of ground
(4) casing PVC 380 (material), (depth) 2 in (size) if telescope see back.
(5) screen 20 ft 380 (length), (depth to top) 2 in 8 slot PVC (size), (material)
(6) pump NA (HP), NA (yield gpm)
(7) electric log No (yes or no)

CODED

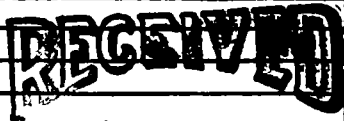

OCT 25 1978


(8) how well bottom plugged sand shank

DRILLERS REMARKS:

MISS. Bd. OF WATER COMMISSIONERS

If well telescopes please sketch and show depths.

GROUND LEVEL

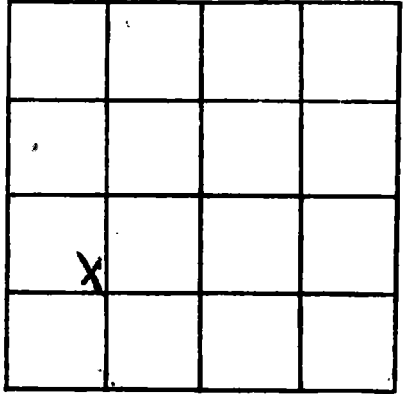

SECTION 32

Please indicate well location X.

ADDITIONAL INFORMATION

If more than one screen, show locations of each on sketch.