

HARRISON
B 105

MISSISSIPPI
BOARD OF WATER COMMISSIONERS
416 North State Street
Jackson, Mississippi 39201

18

CODED

WATER WELL DRILLERS LOG

11/25/80
1980
date well completed
Duncan Well Drilling Harrison
firm name
county well located

LANDOWNER: Bill Martin
P. O. Box 291
Saucier, Ms.
(mailing address)

description of formations encountered	from	to
Clay	0	105
Sand	105	125
Blue Clay	125	280
Fine Sand	280	301
Coarse Sand	301	315

WELL LOCATION:
Sec 14 T. 5 N. R. 12 E.
1 1/2 miles S.W. of Saucier
(distance) (direction) (nearest town)

WELL PURPOSE: Home
(home, irrigation, municipal, industrial)

- WELL COMPLETION DATA:
- (1) diameter (inches) 2"
 - (2) total depth (feet) 315 ft
 - (3) static water level (feet) 60' below top of ground
 - (4) casing PVC 305' (material) (depth)
 - (5) screen 2" PVC 10' 305' (size) (length) (material) (depth to top)
 - (6) pump 1 HP 10 (type power) (yield gpm)
 - (7) electric log (yes or no)

CODED

(organization running log)

(8) how well bottom plugged Sand

DEPT. OF NATURAL RESOURCES
BUREAU OF LAND & WATER RESOURCES

MAY 16 1980


DRILLERS REMARKS:

RECEIVED

If well telescopes please sketch and show depths.

13000

GROUND LEVEL

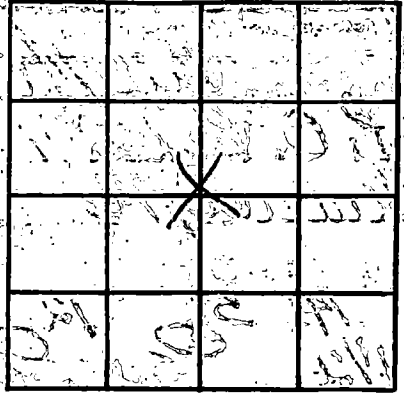

SECTION 14

Please indicate well location X.

ADDITIONAL INFORMATION

If more than one screen,
show locations of each on sketch.