

MISSISSIPPI DEPARTMENT OF NATURAL RESOURCES

Bureau of Land and Water Resources

Southport Mall

P.O. Box 10631

Jackson, Mississippi 39209

WATER WELL DRILLERS LOG

CODED

HARRISON
B 111
9-6-80

9-6-1980 date well completed
Duncan Well Drilling firm name
Harrison county well located

LANDOWNER: Chenter Hatcher
Rt. 1 Box 106 B
Saucier, Mo.
(mailing address)

description of formations encountered	from	to
<u>Top Sand</u>	<u>0</u>	<u>20</u>
<u>white clay</u>	<u>30</u>	<u>90</u>
<u>Blue Clay</u>	<u>90</u>	<u>280</u>
<u>Common Sand</u>	<u>280</u>	<u>294</u>

WELL LOCATION:
sec. 11 T. 45 N. R. 12 E.
2 miles S.W. of Saucier
(distance) (direction) (nearest town)

WELL PURPOSE: Home
(home, irrigation, municipal, industrial)

WELL COMPLETION DATA:

(1) diameter (inches) 2"

(2) total depth (feet) 294'

(3) static water level (feet) 40' ^{below} above top of ground.

(4) casing PVC, 294'
(material) (depth)

(size) if telescope see back.

(5) screen 10', 284'
(length) (depth to top)

2", PVC
(size) (material)

(6) pump 1, 12
(HP) (yield gpm)

electric
(type power)

(7) electric log
(yes or no)

CODED

(organization running log)

(8) how well bottom plugged Spud
Shank

DEPT. OF NATURAL RESOURCES
BUREAU OF LAND & WATER RESOURCES


OCT 31 1980

RECEIVED

DRILLERS REMARKS:

If well telescopes please sketch and show depths.

GROUND LEVEL

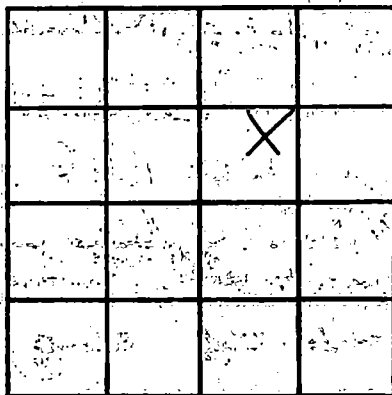

SECTION 11

Please indicate well location X.

ADDITIONAL INFORMATION

RECEIVED

If more than one screen, show locations of each on sketch.