

MISSISSIPPI DEPARTMENT OF NATURAL RESOURCES

Bureau of Land and Water Resources

Southport Mall

P.O. Box 10631

CODED

Jackson, Mississippi 39209

WATER WELL DRILLERS LOG

HARRISON
B 113
9-25-80

9-25-80 date well completed Duncan Well Drilling firm name Harrison county well located

LANDOWNER: Vic Jordan
Rt. 1
Amucier
 (mailing address)

description of formations encountered	from	to
Sand	0	45
Clay	45	110
Blue Clay	110	320
Yucca Clay	320	345
Course sand	345	360

WELL LOCATION:
 sec. 20 T 5 N R. 12 E
5 miles N.E. of Poplar
 (distance) (direction) (nearest town)

WELL PURPOSE: Home
 (home, irrigation, municipal, industrial)

CODED

WELL COMPLETION DATA:
 (1) diameter (inches) 2"
 (2) total depth (feet) 360 ft.
 (3) static water level (feet) 60 below top of ground.
 (4) casing PVC 360'
 (material) (depth)
 (size) if telescope see back.
 (5) screen 10' 350'
 (length) (depth to top)
2" PVC
 (size) (material)
 (6) pump 1 12
 (HP) (yield gpm)
electric
 (type power)
 (7) electric log _____
 (yes or no)

 (organization running log)

DEPT. OF NATURAL RESOURCES
 BUREAU OF LAND & WATER RESOURCES

(8) how well bottom plugged Sand
Shak


OCT 31 1980

RECEIVED

DRILLERS REMARKS: _____

If well telescopes please sketch and show depths.

GROUND LEVEL

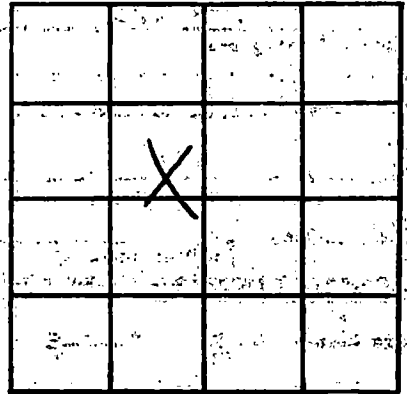

SECTION 20

Please indicate well location X.

ADDITIONAL INFORMATION

If more than one screen, show locations of each on sketch.