

MISSISSIPPI DEPARTMENT OF NATURAL RESOURCES

Bureau of Land and Water Resources

Southport Mall

P.O. Box 10631

CODED

Jackson, Mississippi 39209

WATER WELL DRILLERS LOG

HARRISON
B 114
10-8-80

Oct. 8 1980 Duncan Well Drilling Harrison
date well completed firm name county well located

LANDOWNER: Omer Rivers
Rt. 1
Laudier, Ms.
(mailing address)

description of formations encountered	from	to
white clay	0	80
Blue clay	80	245
fine sand	245	260
course sand	260	275

WELL LOCATION:
sec 22 T 5 N R 12 E
5 miles S.W. of Laudier
(distance) (direction) (nearest town)

WELL PURPOSE: Home
(home, irrigation, municipal, industrial)

CODED

WELL COMPLETION DATA:
(1) diameter (inches) 2"
(2) total depth (feet) 275 ft.
(3) static water level (feet) 60' below above top of ground.
(4) casing PVC, 275'
(material) (depth)
10' if telescope see back.
(size)
(5) screen 10', 265'
(length) (depth to top)
2", PVC
(size) (material)
(6) pump 10
(HP) (yield gpm)
electric
(type power)
(7) electric log (yes or no)

DEPT. OF NATURAL RESOURCES
BUREAU OF LAND & WATER RESOURCES

(8) how well bottom plugged land
thrust
(organization running log)


OCT 31 1980

DRILLERS REMARKS:

RECEIVED

If well telescopes please sketch and show depths.

GROUND LEVEL

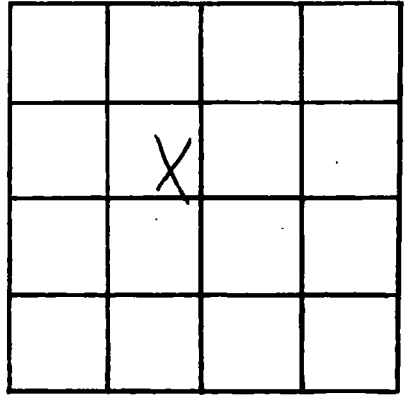

SECTION 22

Please indicate well location X.

ADDITIONAL INFORMATION

If more than one screen, show locations of each on sketch.