

HARRISON
B 115
10-7-80

MISSISSIPPI
BOARD OF WATER COMMISSIONERS
416 North State Street
Jackson, Mississippi 39201

CODED

WATER WELL DRILLERS LOG

10-7-80

BRADEN PUMP AND WELL SERVICE, INC HARRISON

date well completed

firm name

county well located

LANDOWNER:	description of formations encountered	from	to
William Rust 116 So. Kears Dr. Hound Springs, MS 39507 (mailing address)	CLAY	0	100
WELL LOCATION: sec. 36 T. 5 N. R. 12 E. 7.3 miles S of SAUKR (distance) (direction) (nearest town)	SAND	100	110
WELL PURPOSE: home (home, irrigation, municipal, industrial)	CLAY	110	120
WELL COMPLETION DATA: (1) diameter (inches) 11"	SAND	120	135
(2) total depth (feet) 260	CLAY	135	140
(3) static water level (feet) 105' below top of ground.	SAND	140	145
(4) casing PVC, total 2" (size) If telescope see back.	CLAY	145	160
(5) screen 10' length, 235' depth to top.	SAND	160	200
(6) pump 2" PVC under bar (size), 10 (yield gpm)	CLAY	200	205
(7) electric log NO (yes or no)	SAND	205	220
(8) how well bottom plugged 2" sand shark	CLAY	220	260
DRILLERS REMARKS: 15' tail pipe	CLAY	260	260

CODED


DEPT. OF NATURAL RESOURCES
BUREAU OF LAND & WATER RESOURCES

JAN 28 1981

RECEIVED

If well telescopes please sketch and show depths.

GROUND LEVEL

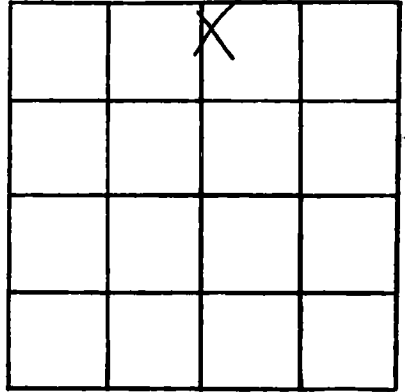

SECTION _____

Please indicate well location X.

ADDITIONAL INFORMATION

If more than one screen,
show locations of each on sketch.