

MISSISSIPPI DEPARTMENT OF NATURAL RESOURCES

Bureau of Land and Water Resources

Southport Mall

P.O. Box 10631

Jackson, Mississippi 39209

WATER WELL DRILLERS LOG

CODED

Change

N-2 ADIVER

HARRISON
B 116
10-14-80

Oct 14 1980 *E-B* HARRISON
date well completed firm name county well located

LANDOWNER:
MARLIN LADNER
RT SAUCIER MS
(mailing address)

description of formations encountered	from	to
TOP SOIL	0	10
CLAY Red	10	20
CLAY Grey Red	20	30
Grey white CLAY	30	40
Red SAND	50	60
Red SAND	60	70
White SAND	70	80
" "	80	88

WELL LOCATION: SAUCIER
sec. 32 T 5 N R 12 W R.D.
4 1/2 miles SW of SAUCIER
(distance) (direction) (nearest town)

WELL PURPOSE:
(home, irrigation, municipal, industrial)

WELL COMPLETION DATA:

(1) diameter (inches) 2"

(2) total depth (feet) 88

(3) static water level (feet) 47 below top of ground.

(4) casing PLASC 78 (material), (depth) (size) If telescope see back.

(5) screen 10 78 (length), (depth to top) 2 PLASTIC (size), (material)

(6) pump 1 5 1/2 (HP), (yield gpm) Elec (type power)

(7) electric log NO (yes or no)

(organization running log)

(8) how well bottom plugged PLASTIC CAP

CODED

DEPT. OF NATURAL RESOURCES
BUREAU OF LAND & WATER RESOURCES


DEC - 3 1980

RECEIVED

DRILLERS REMARKS:

If well telescopes please sketch and show depths.

GROUND LEVEL

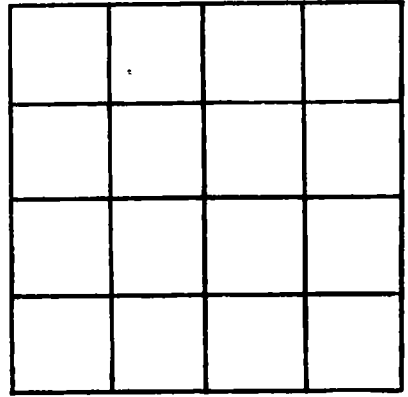

SECTION _____

Please indicate well location X.

ADDITIONAL INFORMATION

If more than one screen, show locations of each on sketch.