

MISSISSIPPI DEPARTMENT OF NATURAL RESOURCES

Bureau of Land and Water Resources

Southport Mall

P.O. Box 10631

CODED

Jackson, Mississippi 39209

WATER WELL DRILLERS LOG

HARRISON
B 117
9/6/80
9-6

date well completed

1980 *Lunar Well Drilling* *Harrison*
firm name county well located

LANDOWNER: *Chester Prather*

description of formations encountered

from

to

Rt. 1 Box 100B

clay	0	15
sand	15	60
Blue Clay	60	250
fine sand	250	280
course sand	280	294

Saucier, Ms. 39574
(mailing address)

WELL LOCATION:

sec *14* T *5* N R *12* E
3 miles *SW* of *Saucier*
(distance) (direction) (nearest town)

WELL PURPOSE: *home*
(home, irrigation, municipal, industrial)

WELL COMPLETION DATA:

- (1) diameter (inches) *2"*
- (2) total depth (feet) *294'*
- (3) static water level (feet) *60'* below top of ground
- (4) casing *PVC*, *284'*
(material) (depth)

- (5) screen *10'*, *284'*
(length) (depth to top)

- (6) pump *1*, *PVC*
(size) (material)
- (7) pump *1*, *12*
(HP) (yield gpm)
- electric*
(type power)

- (7) electric log (yes or no)

(organization running log)

- (8) how well bottom plugged *Sand Mark*

CODED

DEPT. OF NATURAL RESOURCES
BUREAU OF LAND & WATER RESOURCES


MAR 18 1981

DRILLERS REMARKS:

RECEIVED

If well telescopes please sketch and show depths.

GROUND LEVEL

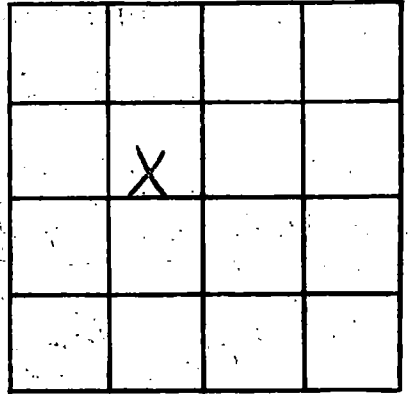

SECTION 14

Please indicate well location X.

ADDITIONAL INFORMATION

If more than one screen, show locations of each on sketch.