

MISSISSIPPI DEPARTMENT OF NATURAL RESOURCES

Bureau of Land and Water Resources

Southport Mall

P.O. Box 10631

Jackson, Mississippi 39209

CODED

WATER WELL DRILLERS LOG A

HARRISON
B 119
2/20/81

2-20 1981 Duncan Well Drilling Harrison
date well completed firm name county well located

LANDOWNER: A. C. Brasher
Route 6 Box 306
Columbia La
(mailing address)

description of formations encountered	from	to
Clay	0	15
Sand	15	30
White Clay	30	120
Blue Clay	120	285
Iron sand	285	330
Course Sand	330	357

WELL LOCATION:
sec. 6 T. 5 N. R. 12 E.
6 miles W. of Saucier
(distance) (direction) (nearest town)

WELL PURPOSE: Home
(home, irrigation, municipal, industrial)

WELL COMPLETION DATA:

- (1) diameter (Inches) 2
- (2) total depth (feet) 357
- (3) static water level (feet) 134 ^{below} _{above} top of ground.
- (4) casing Pvc, 357,
(material) (depth)
2
(size) if telescope see back.
- (5) screen 10, 347
(length) (depth to top)
2, Pvc
(size) (material)
- (6) pump 2, 10
(HP) (yield gpm)
Electric
(type power)
- (7) electric log no
(yes or no)

CODED

DEPT. OF NATURAL RESOURCES
BUREAU OF LAND & WATER RESOURCES

(organization running log)

(8) how well bottom plugged Sandstone

DRILLERS REMARKS:


MAR 18 1981

RECEIVED

If well telescopes please sketch and show depths.

1100

GROUND LEVEL

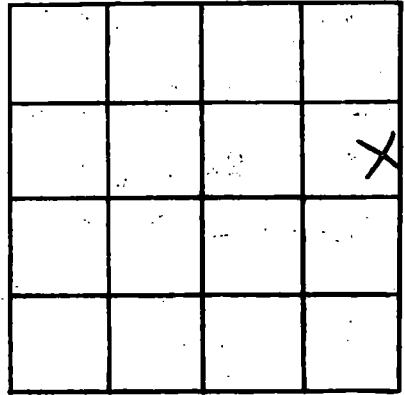

SECTION 6

Please indicate well location X.

ADDITIONAL INFORMATION

If more than one screen, show locations of each on sketch.