

MISSISSIPPI DEPARTMENT OF NATURAL RESOURCES

Bureau of Land and Water Resources

Southport Mall

P.O. Box 10631

Jackson, Mississippi 39209

WATER WELL DRILLERS LOG

CODED

HARRISON
B 120
3/27/81

3/27/81 date well completed
Lyman Well Co. firm name
Harrison county well located

LANDOWNER:

W.L. Hickman

description of formations encountered

from

to

Rt 1 Box 557

Lancien, Mo

(mailing address)

Reg. clay yellow clay	0	23
Reg. sand clay	23	42
Blue clay	42	130
SAND very good	130	168

WELL LOCATION:

sec. 24 T 5 N R 12 E
3 miles S of Sanger
(distance) (direction) (nearest town)

WELL PURPOSE:

home (home, irrigation, municipal, industrial)

CODED

WELL COMPLETION DATA:

- (1) diameter (inches) 2"
- (2) total depth (feet) 168'
- (3) static water level (feet) 44' below top of ground
- (4) casing PVC 158' (material) (depth)
2" (size) if telescope see back.
- (5) screen 10' 158' (length) (depth to top)
2" PVC (size) (material)
- (6) pump (HP) (yield gpm)



(7) electric log No (yes or no)

No (organization running log)

(8) how well bottom plugged sand shark

DEPT. OF NATURAL RESOURCES
BUREAU OF LAND & WATER RESOURCES

MAY 20 1981


RECEIVED

DRILLERS REMARKS:

Existing well suppose to be 900 ft about 8 year old, produces 1/2 gal per min

If well telescopes please sketch and show depths.

GROUND LEVEL

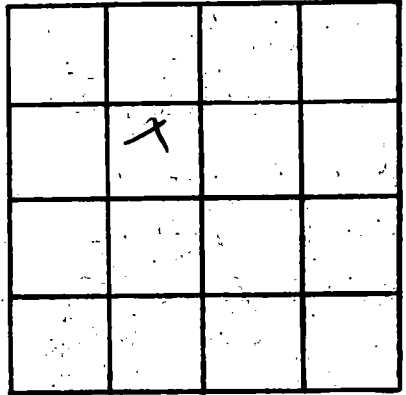

SECTION _____

Please indicate well location X.

ADDITIONAL INFORMATION

If more than one screen, show locations of each on sketch.