

Harrison
 B 123
 6-4-81

MISSISSIPPI
 BOARD OF WATER COMMISSIONERS
 416 North State Street
 Jackson, Mississippi 39201

CODED

WATER WELL DRILLERS LOG
 BRADEN PUMP AND WELL SERVICE, INC.

6-4-81 19 ROUTE 1, BOX 489 HARRISON
 date well completed firm name county well located
 SAUCIER, MS 39574

LANDOWNER:
 John Hight
 P.O. Box 314
 SAUCIER Miss
 (mailing address)

description of formations encountered	from	to
CLAY	0	20
SAND	20	80
CLAY	80	220
SAND & CLAY	220	235
SAND	235	260

WELL LOCATION:
 sec. 12 T. 5 N R. 12 E
 (distance) miles in (direction) of SAUCIER (nearest town)

CODED

WELL PURPOSE: HOME
 (home, irrigation, municipal, industrial)

WELL COMPLETION DATA:

(1) diameter (inches) 2

(2) total depth (feet) 260'

(3) static water level (feet) 85 below top of ground

(4) casing PVC, total (material) (depth)
 2" (size) if telescope see back.


(5) screen 10' 245 (length) (depth to top)
 2" PVC underdrain (size) (material)

(6) pump 1 (HP) 8 (yield gpm)
 110 (type power)

(7) electric log NO (yes or no)

(organization running log)


(8) how well bottom plugged 2" SAND SHANK

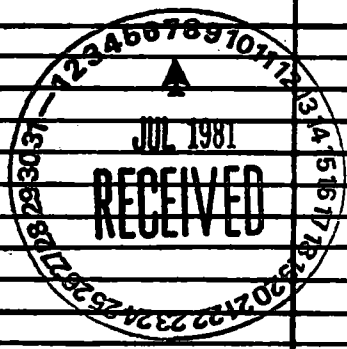

DRILLERS REMARKS:
 5' tail pipe

If well telescopes please sketch and show depths.

GROUND LEVEL

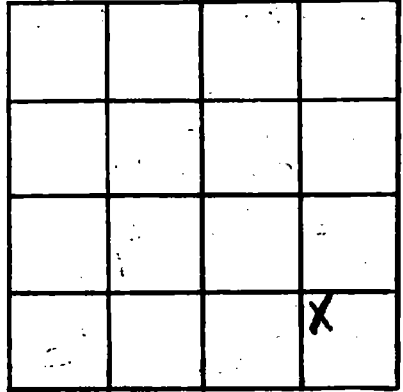

SECTION 12

Please indicate well location X.

ADDITIONAL INFORMATION

If more than one screen, show locations of each on sketch.