

MISSISSIPPI DEPARTMENT OF NATURAL RESOURCES

Bureau of Land and Water Resources

Southport Mall

P.O. Box 10631

Jackson, Mississippi 39209

WATER WELL DRILLERS LOG

CODED

HARRISON
B 126
5-25-81

May 25 1981 Duncan Well Drilling Services
date well completed firm name county well located

LANDOWNER: Clarence Hall
Rt. 1 Box 618
Sauvies, Ms.
(mailing address)

description of formations encountered	from	to
<u>Clay</u>	<u>0</u>	<u>43</u>
<u>Blue Clay</u>	<u>43</u>	<u>158</u>
<u>fine sand</u>	<u>158</u>	<u>165</u>
<u>course sand</u>	<u>165</u>	<u>180</u>

WELL LOCATION:
sec. 35 T. 74 N. R. 12 E.
3 miles NW of Sauvies
(distance) (direction) (nearest town)

WELL PURPOSE: None
(home, irrigation, municipal, industrial)

CODED

- WELL COMPLETION DATA:
- (1) diameter (inches) 2"
 - (2) total depth (feet) 180 feet
 - (3) static water level (feet) 75' ^{below} / _{above} top of ground.
 - (4) casing 2" / 180'
(material) (depth)
 - (size) if telescope see back.
 - (5) screen 10' / 170'
(length) (depth to top)
 - (size) / PVC
(material)
 - (6) pump 1 / 12
(HP) (yield gpm)
 - electric
(type power)
 - (7) electric log yes or no


(organization running log)
(8) how well bottom plugged Sand
shark

DRILLERS REMARKS:

DEPT. OF NATURAL RESOURCES
BUREAU OF LAND & WATER RESOURCES
OCT 19 1981
RECEIVED

If well telescopes please sketch and show depths.

GROUND LEVEL

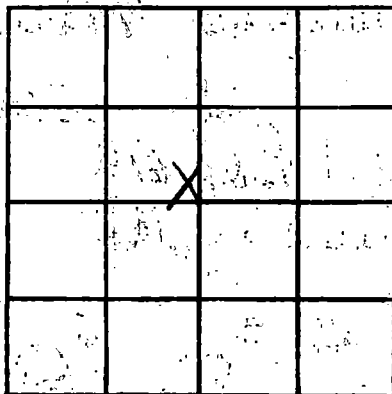

SECTION 35

Please indicate well location X.

ADDITIONAL INFORMATION

If more than one screen, show locations of each on sketch.