

MISSISSIPPI DEPARTMENT OF NATURAL RESOURCES

Bureau of Land and Water Resources

Southport Mall

P.O. Box 10631

Jackson, Mississippi 39209

WATER WELL DRILLERS LOG

Harrison  
B 131

CODED

1

Oct. 22 1981 Duncan Well Drilling Harrison  
date well completed firm name county well located

LANDOWNER: J. B. Keop  
106 Carmen St.  
Southport, Mo. 39501  
(mailing address)

description of formations encountered	depth	
	from	to
<u>Top Sand</u>	<u>0</u>	<u>30</u>
<u>Sandy Blue &amp; Red Clay</u>	<u>30</u>	<u>120</u>
<u>Course Sand</u>	<u>120</u>	<u>130</u>

WELL LOCATION:  
sec. 2 T. 5 N. R. 12 E.  
1.5 miles NW of Lyman  
(distance) (direction) (nearest town)

WELL PURPOSE: House  
(home, irrigation, municipal, industrial)

WELL COMPLETION DATA:

- (1) diameter (inches) 2"
- (2) total depth (feet) 130 ft.
- (3) static water level (feet) 30' <sup>below</sup> above top of ground.
- (4) casing PVC, 120'  
(material) (depth)
- (5) screen 10', 120'  
(length) (depth to top)
- 2", PVC  
(size) (material)
- (6) pump 1 (HP) 10 (yield gpm)  
electric  
(type power)
- (7) electric log         
(yes or no)

CODED

(organization running log) Land Shark

(8) how well bottom plugged? Land Shark

DRILLERS REMARKS:

DEPT. OF NATURAL RESOURCES  
BUREAU OF LAND & WATER RESOURCES


FEB 11 1982

RECEIVED

20

If well telescopes please sketch and show depths.

GROUND LEVEL

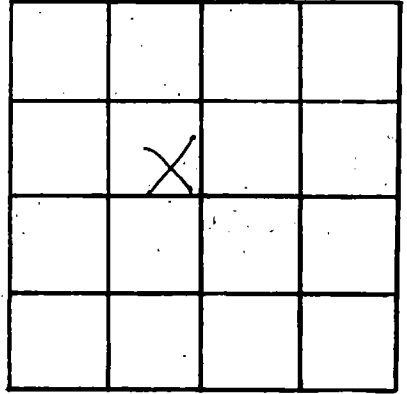

SECTION 2

Please indicate well location X.

ADDITIONAL INFORMATION

Lined area for additional information.

If more than one screen, show locations of each on sketch.

33096