

MISSISSIPPI DEPARTMENT OF NATURAL RESOURCES

Bureau of Land and Water Resources

Southport Mall

P.O. Box 10631

Jackson, Mississippi 39209

WATER WELL DRILLERS LOG

Harrison
B132

CODED

12/10/81 19 Sipman Well Co. Harrison
date well completed firm name county well located

LANDOWNER: J.C. Parker
Rt. 1, Box 772
Saucier, Md 39574
(mailing address)

description of formations encountered	from	to
<u>Red sand</u>	<u>0</u>	<u>51</u>
<u>fine sand blue clay</u>	<u>51</u>	<u>110</u>
<u>Medium Fine sand</u>	<u>110</u>	<u>156</u>

WELL LOCATION:
sec 13 T 5 N R 12 E
2 miles S of Saucier
(distance) (direction) (nearest town)

WELL PURPOSE: home
(home, irrigation, municipal, industrial)

- WELL COMPLETION DATA:
- (1) diameter (inches) 2"
 - (2) total depth (feet) 156'
 - (3) static water level (feet) 75 below above top of ground.
 - (4) casing PVC 146'
(material) (depth)
2" if telescope see back.
(size)
 - (5) screen 10' 146'
(length) (depth to top)
2" PVC
(size) (material)
 - (6) pump NA NA
(HP) (yield gpm)
NA
(type power)
 - (7) electric log NO
(yes or no)
NO
(organization running log)
 - (8) how well bottom plugged sand shark

CODED

DEPT. OF NATURAL RESOURCES
BUREAU OF LAND & WATER RESOURCES


APR 29 1982

RECEIVED

DRILLERS REMARKS:

If well telescopes please sketch and show depths.

GROUND LEVEL

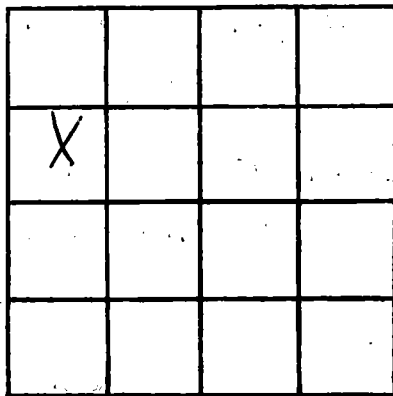

SECTION 13

Please indicate well location X.

ADDITIONAL INFORMATION

If more than one screen, show locations of each on sketch.