

MISSISSIPPI DEPARTMENT OF NATURAL RESOURCES  
 Bureau of Land and Water Resources  
 Southport Mall  
 P.O. Box 10631

Jackson, Mississippi 39209  
**WATER WELL DRILLERS LOG**

CODED

Harrison  
B 133

4-15-82 date well completed      Frank Price firm name      Harrison county well located

LANDOWNER:	description of formations encountered	from	to
<u>Ascar Lee</u>	<u>Top Soil</u>	<u>0</u>	<u>2</u>
(mailing address)	<u>Sandy Clay</u>	<u>2</u>	<u>38</u>
WELL LOCATION:	<u>Blue Clay</u>	<u>38</u>	<u>160</u>
sec <u>24 T 5 S R 12 W</u>	<u>Fine Sand</u>	<u>160</u>	<u>170</u>
<u>1 1/2</u> miles <u>S</u> of <u>SARCIER</u>	<u>Blue Clay</u>	<u>170</u>	<u>290</u>
(distance) (direction) (nearest town)	<u>Fine Sand</u>	<u>290</u>	<u>310</u>
WELL PURPOSE: <u>HOME</u>	<u>Course Sand</u>	<u>310</u>	<u>320</u>
(home, irrigation, municipal, industrial)			
WELL COMPLETION DATA:			
(1) diameter (inches) <u>2"</u>			
(2) total depth (feet) <u>320'</u>			
(3) static water level (feet) <u>45'</u> below top of ground.			
(4) casing <u>Plastic 315'</u> (material) (depth)			
(size) If telescope see back.			
(5) screen <u>5'</u> <u>315'</u> (length) (depth to top)			
<u>2"</u> <u>Plastic</u> (size) (material)			
(6) pump <u>1</u> <u>9</u> (HP) (yield gpm)			
<u>Elect</u> (type power)			
(7) electric log <u>no</u> (yes or no)			
(organization running log)			
(8) how well bottom plugged <u>Backwash Valve</u>			

CODED

DEPT. OF NATURAL RESOURCES  
 BUREAU OF LAND & WATER RESOURCES


MAY 10 1982

RECEIVED

DRILLERS REMARKS:

If well telescopes please sketch and show depths.

GROUND LEVEL

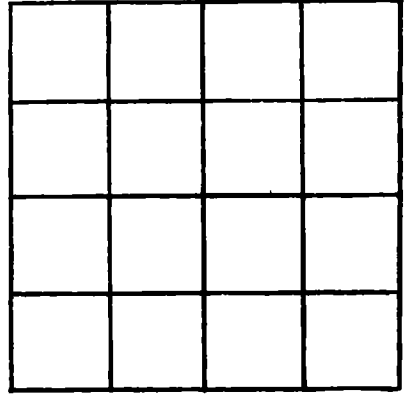

SECTION \_\_\_\_\_

Please indicate well location X.

ADDITIONAL INFORMATION

If more than one screen, show locations of each on sketch.