

MISSISSIPPI DEPARTMENT OF NATURAL RESOURCES

Bureau of Land and Water Resources

Southport Mall

P.O. Box 10631

Jackson, Mississippi 39209

WATER WELL DRILLERS LOG

Harrison
B 135

CODED

12/81 19 Syman Well Co. Harrison
date well completed firm name county well located

LANDOWNER: Thos. Bishop
Rt. 2, Byrones Rd.
Saucier, Ms. 39574
(mailing address)

description of formations encountered	from	to
<u>Red sand gravel</u>	<u>0</u>	<u>72</u>

WELL LOCATION:
sec. 11 T. 5 N. R. 14 E.
5 miles S 5 W of Saucier
(distance) (direction) (nearest town)

WELL PURPOSE: Home
(home, irrigation, municipal, industrial)

WELL COMPLETION DATA:

(1) diameter (inches) 4"

(2) total depth (feet) 72'

(3) static water level (feet) 30' below above top of ground.

(4) casing PVC, 62',
(material) (depth)
4"
(size) If telescope see back.

(5) screen 20', 52'
(length) (depth to top)
4", PVC
(size) (material)

(6) pump 1, 34
(HP) (yield gpm)
electric
(type power)

(7) electric log NO
(yes or no)
NO
(organization running log)

CODED

(8) how well bottom plugged sand
shark

DRILLERS REMARKS:


DEPT. OF NATURAL RESOURCES
BUREAU OF LAND & WATER RESOURCES

JUL 14 1982

RECEIVED

If well telescopes please sketch and show depths.

GROUND LEVEL

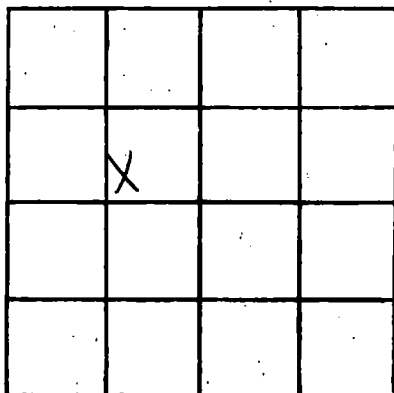

SECTION 11

Please indicate well location X.

ADDITIONAL INFORMATION

If more than one screen, show locations of each on sketch.