

MISSISSIPPI DEPARTMENT OF NATURAL RESOURCES

Bureau of Land and Water Resources

Southport Mall

P.O. Box 10631

Jackson, Mississippi 39209

WATER WELL DRILLERS LOG

CODED

Harrison
B136

July 5 1982 Duncan Well Drilling Harrison
date well completed firm name county well located

LANDOWNER: <u>Roland Prosser</u>	description of formations encountered	from	to
<u>125 Eden</u> <u>Los Christian</u> (mailing address)			
	<u>clay</u>	<u>0</u>	<u>20</u>
	<u>sand</u>	<u>20</u>	<u>100</u>
	<u>blue clay</u>	<u>100</u>	<u>275</u>
	<u>course sand</u>	<u>275</u>	<u>315</u>

WELL LOCATION:

sec 30 T 5 N R 13 E
(distance) miles (direction) of Osiana
(nearest town)

WELL PURPOSE: home
(home, irrigation, municipal, industrial)

WELL COMPLETION DATA:

(1) diameter (inches) 2"
(2) total depth (feet) 315 ft.
(3) static water level (feet) 20' below above top of ground.

(4) casing PVC 305'
(material) (depth)

(size) If telescope see back.

(5) screen 10' 305'
(length) (depth to top)

2" PVC
(size) (material)

(6) pump _____ (HP) _____ (yield gpm)

electric
(type power)

(7) electric log _____ (yes or no)

(organization running log)

(8) how well bottom plugged hard

DRILLERS REMARKS: Owner has his own pump

CODED


DEPT. OF NATURAL RESOURCES
BUREAU OF LAND & WATER RESOURCES

AUG 30 1982

RECEIVED

If well telescopes please sketch and show depths.

GROUND LEVEL

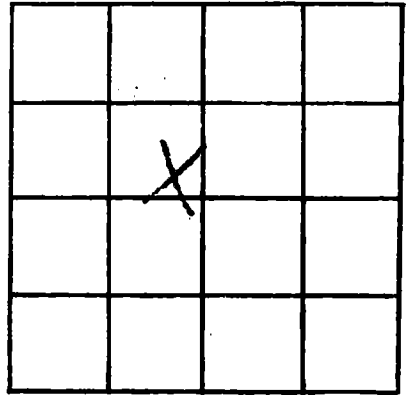

SECTION 30

Please indicate well location X.

ADDITIONAL INFORMATION

If more than one screen,
show locations of each on sketch.