

MISSISSIPPI DEPARTMENT OF NATURAL RESOURCES

Bureau of Land and Water Resources

Southport Mall

P.O. Box 10631

Jackson, Mississippi 39209

WATER WELL DRILLERS LOG

COASTAL DRILLING & SERVICE CO.

CODED

Harrison
B 139

8/20/72
date well completed

ROUTE 1 BOX 418
name

Harrison
county well located

BILOXI MISS. 39532

LANDOWNER Druid galloway

description of formations encountered	from	to
<u>top soil</u>	<u>1</u>	<u>3</u>
<u>Red Clay</u>	<u>3</u>	<u>15</u>
<u>white silty clay</u>	<u>15</u>	<u>30</u>
<u>Coarse white sand</u>	<u>30</u>	<u>60</u>
<u>Soft Blue Clay</u>	<u>60</u>	<u>95</u>
<u>fine water sand</u>	<u>95</u>	<u>120</u>
<u>Soft Blue Clay</u>	<u>120</u>	<u>230</u>
<u>hard Blue Clay</u>	<u>230</u>	<u>390</u>
<u>fine water sand</u>	<u>390</u>	<u>420</u>
<u>very coarse sand</u>	<u>420</u>	<u>440</u>

Sauvion ms

Sauvion Creek
(mailing address)
Biloxi River

WELL LOCATION:

sec. 22 T. 5 N. R. 12 E.
Biloxi River
(distance) (direction) (nearest town)

WELL PURPOSE: home
(home, irrigation, municipal, industrial)

WELL COMPLETION DATA:

- (1) diameter (inches) 2"
- (2) total depth (feet) 440'
- (3) static water level (feet) 5' below top of ground.
- (4) casing 430'
(material) (depth)
- (size) If telescope see back.
- (5) screen 10' 430'
(length) (depth to top)
- 2" PVC
(size) (material)
- (6) pump 1/2 one 15
(HP) (yield gpm)
- 440
(type power)
- (7) electric log no
(yes or no)

CODED


(organization running log)

(8) how well bottom plugged
2' back dash distance

DRILLERS REMARKS: 19-B

If well telescopes please sketch and show depths.

GROUND LEVEL

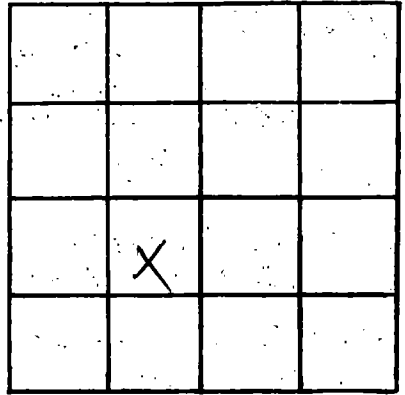

SECTION _____

Please indicate well location X.

ADDITIONAL INFORMATION

If more than one screen,
show locations of each on sketch.