

MISSISSIPPI DEPARTMENT OF NATURAL RESOURCES

Bureau of Land and Water Resources

Southport Mall

P.O. Box 10631

Jackson, Mississippi 39209

CODED

COASTAL DRILLING & SERVICE CO. WATER WELL DRILLERS LOG

ROUTE 1 BOX 618

BILOXI, MISS. 39532

county well located

Harrison
B 140

date well completed

4/18/82

Harrison

LANDOWNER

Paul Chapman

description of formations encountered

from to

old yard

top soil

1 3

Sardinia

Red Clay

3 20

(mailing address)

White Sand

20 45

WELL LOCATION:

sec 24 T 5 S R 12 E W

Sugar Sand

45 60

Honey Branch

Light Blue Clay

60 190

(distance) (direction) (nearest town)

Hard Blue Clay

190 315

WELL PURPOSE:

(home, irrigation, municipal, industrial)

Home

WELL COMPLETION DATA:

(1) diameter (inches) 4 1/2"

(2) total depth (feet) 350'

(3) static water level (feet) 60' below top of ground

(4) casing (material) (depth) 335'

4 1/2" If telescope see back.

(5) screen (length) (depth to top) 15' 335'

2" PVC

(6) pump (HP) (yield gpm) 1 1/2 HP 22

Electric

(7) electric log (yes or no) no

(organization running log)

(8) how well bottom plugged

2 inch mesh valve

DRILLERS REMARKS: 190

CODED

DEPT. OF NATURAL RESOURCES
BUREAU OF LAND & WATER RESOURCES

OCT 14 1982

RECEIVED

If well telescopes please sketch and show depths.

GROUND LEVEL

160' 4" Pk Casing


175' 2" Pk Casing

15' 2" Pk Screen

2" back wash valve

19-13

If more than one screen, show locations of each on sketch.

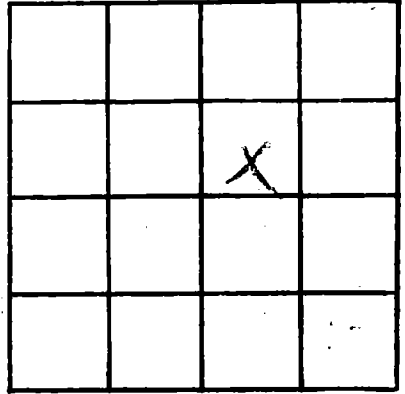

SECTION _____

Please indicate well location X.

ADDITIONAL INFORMATION

Multiple horizontal lines for additional information.