

MISSISSIPPI DEPARTMENT OF NATURAL RESOURCES
 Bureau of Land and Water Resources
 Southport Mall
 P.O. Box 10631
 Jackson, Mississippi 39209
WATER WELL DRILLERS LOG

CODED

Harrison
B 142

1/4/83 1983 Raymen Well Co Harrison
 date well completed firm name county well located

LANDOWNER:
DON VAN KAMPEN
Rt. 1, Box 547 Saucier
 (mailing address)

description of formations encountered	from	to
<u>Red & White Clay</u>	<u>0</u>	<u>100</u>
<u>Fine Sand</u>		
<u>Medium Sand</u>	<u>100</u>	<u>120</u>
<u>Blue Gumbo Clay</u>	<u>120</u>	<u>200</u>
<u>Hard Sand</u>	<u>200</u>	<u>233</u>

WELL LOCATION:
 sec 35 T 5 N R 12 E
8 miles S of Saucier
 (distance) (direction) (nearest town)

WELL PURPOSE: Home
 (home irrigation, municipal, industrial)

- WELL COMPLETION DATA:
- (1) diameter (inches) 2"
 - (2) total depth (feet) 233
 - (3) static water level (feet) 58 below above top of ground.
 - (4) casing PVC, 223
 (material) (depth)
2" If telescope see back.
 (size)
 - (5) screen 10', 233
 (length) (depth to top)
2", PVC
 (size) (material)
 - (6) pump 1, 12
 (HP) (yield gpm)
Elect
 (type power)
 - (7) electric log NO
 (yes or no)
ND
 (organization running log)
 - (8) how well bottom plugged Sand
3 inch

CODED

DEPT. OF NATURAL RESOURCES
 BUREAU OF LAND & WATER RESOURCES


FEB 28 1983

RECEIVED

DRILLERS REMARKS:

If well telescopes please sketch and show depths.

GROUND LEVEL

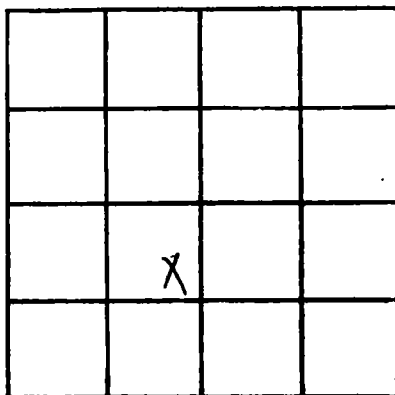

SECTION 35

Please indicate well location X.

ADDITIONAL INFORMATION

If more than one screen, show locations of each on sketch.