

MISSISSIPPI DEPARTMENT OF NATURAL RESOURCES

Bureau of Land and Water Resources

Southport Mall

P.O. Box 10631

Jackson, Mississippi 39209

WATER WELL DRILLERS LOG

CODED

Harrison
B143
03/01/83

19 BRADEN Pump & WELL SERV^{INC} HARRISON
date well completed firm name county well located

LANDOWNER: Charles Childers
Rt. 3, Box 153
Nicksman Rd

description of formations encountered

from to

Saucier Ms. 39574
(mailing address)

Red clay	0	30
Sand	30	50
white clay	50	60
Blue clay	60	140
grey sand	140	180

WELL LOCATION:

sec. 11 T 5 N R 12 E
S S W
1 1/2 miles W of Saucier
(distance) (direction) (nearest town)

WELL PURPOSE: Home
(home, irrigation, municipal, industrial)

CODED

WELL COMPLETION DATA:

- (1) diameter (inches) 2"
- (2) total depth (feet) 180
- (3) static water level (feet) 68 below above top of ground.
- (4) casing 5/8" to PVC 160
(material) (depth)
2"
(size) If telescope see back.
- (5) screen 10 FT. 160
(length) (depth to top)
2" PVC Underbar
(size) (material)
- (6) pump 1 220-18
(HP) (yield gpm)
(type power)
- (7) electric log No
(yes or no)

(organization running log)

DEPT. OF NATURAL RESOURCES
BUREAU OF LAND & WATER RESOURCES

(8) how well bottom plugged:
2" PVC SandShark


MAR - 8 1983

DRILLERS REMARKS: 10 ft T/P

RECEIVED

If well telescopes please sketch and show depths.

GROUND LEVEL

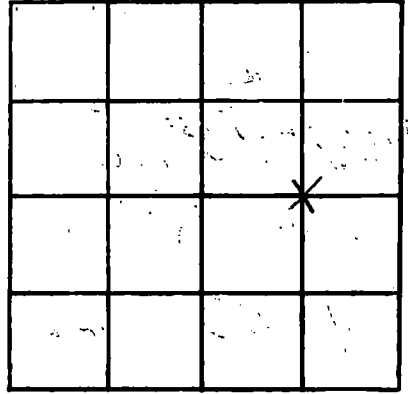

SECTION 11

Please indicate well location X.

ADDITIONAL INFORMATION

If more than one screen,
show locations of each on sketch.